



As Laid Drainage

Working Together

Building Consent Number: 2022/44717 Date: 2, 9, 22 No. of pages: ①

Builder: HOMES FOR LIVING


Owner:

Address: LOT 5/4 14 COGAR TCE, PARKWOOD

Drain Layer Name: HAMISH MCKENZIE [Please print clearly] Signature: *[Signature]*

Registration Number: 21413 Business Name: DRAINAGE SYSTEMS

To Council: (Tick) Hauraki Matamata-Piako Waitomo Otorohanga Thames-Coromandel Waipa Waikato Hamilton

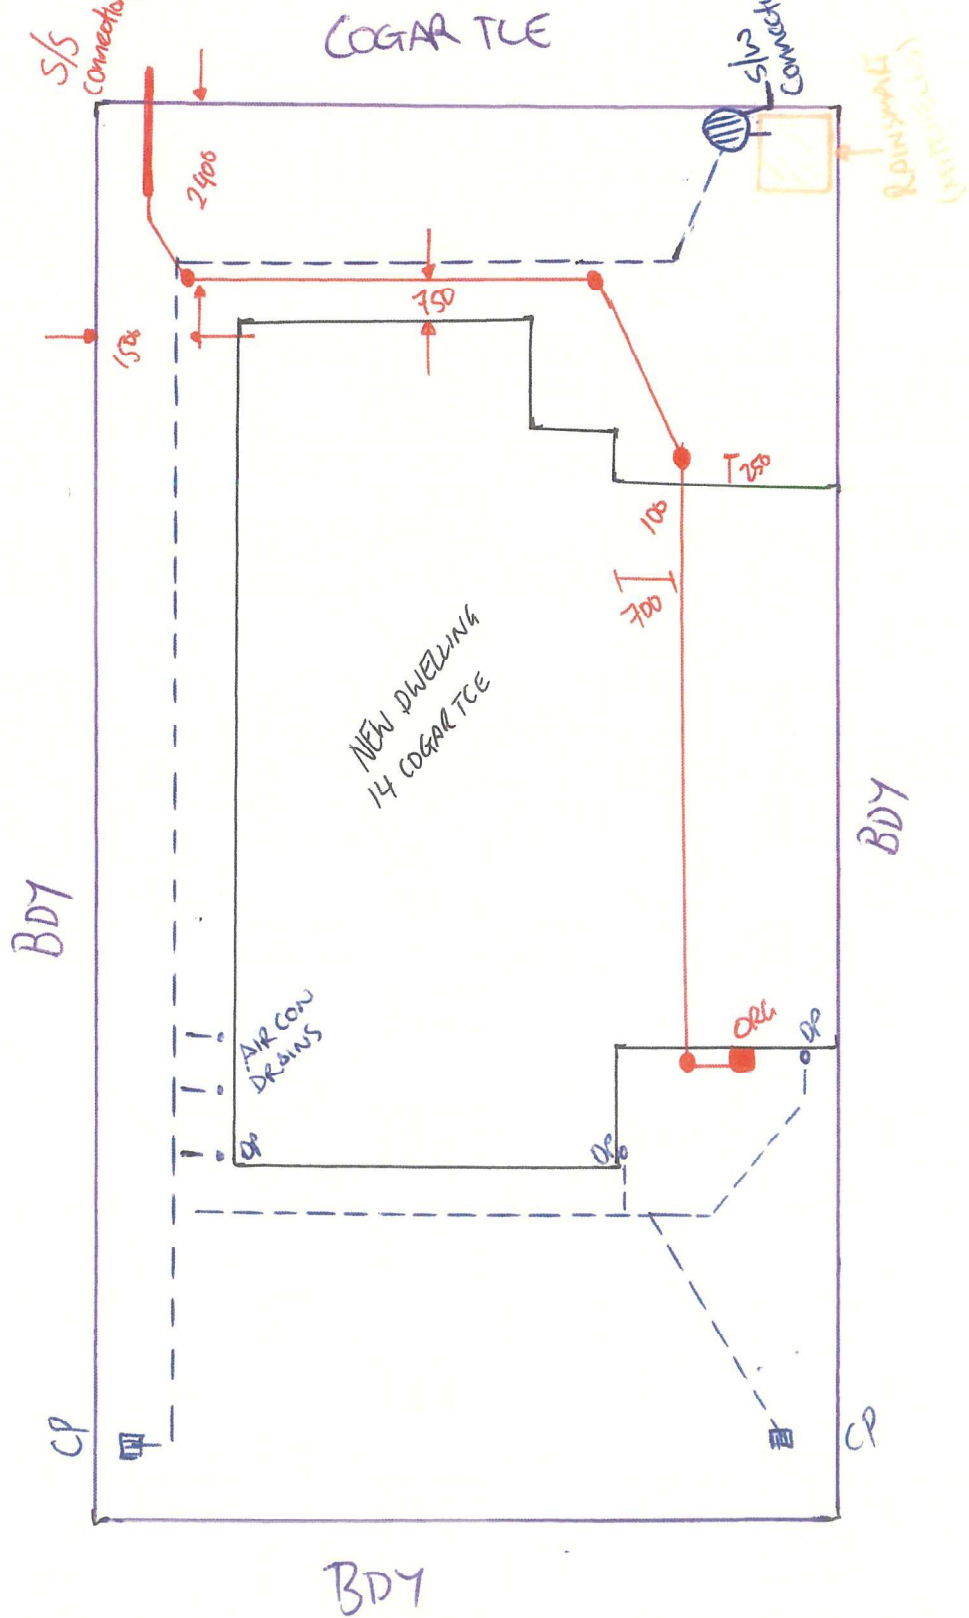

DRAINAGE SYSTEMS LTD

residential, commercial & environmental drainage

2 - 09 - 2022

Homes for Living Ltd
P.O Box 28023
Hamilton

P.S 3 Producer Statement Construction
14 Cogar Terrace, Parkwood (Lot 514)
Hamilton City Council Consent No. 2022/44717

The Stormwater management system to the above contract was constructed and installed by Drainage Systems Ltd.
Construction was in accordance with the engineer's design by Mark T Mitchell Ltd Engineers.

If you have any queries concerning the above, please contact me on 021 548 115.

Regards.



Ollie Silverton

p 07 850 4370
m 021 548 115
a PO Box 27026, Hamilton 3257
e ollie@drainagesystems.co.nz
w www.drainagesystems.co.nz