


HAMILTON CITY COUNCIL
As Laid Drainage Plan

Owner: J. Crush
Street: 1 Sheriff Pl
Consent No: 96/1490

Lot: 35 DP/S 18252
Drainlayer: K. R. Wood / No
Date of Inspection: 12/3/96
Inspector: P. C. O'Connell

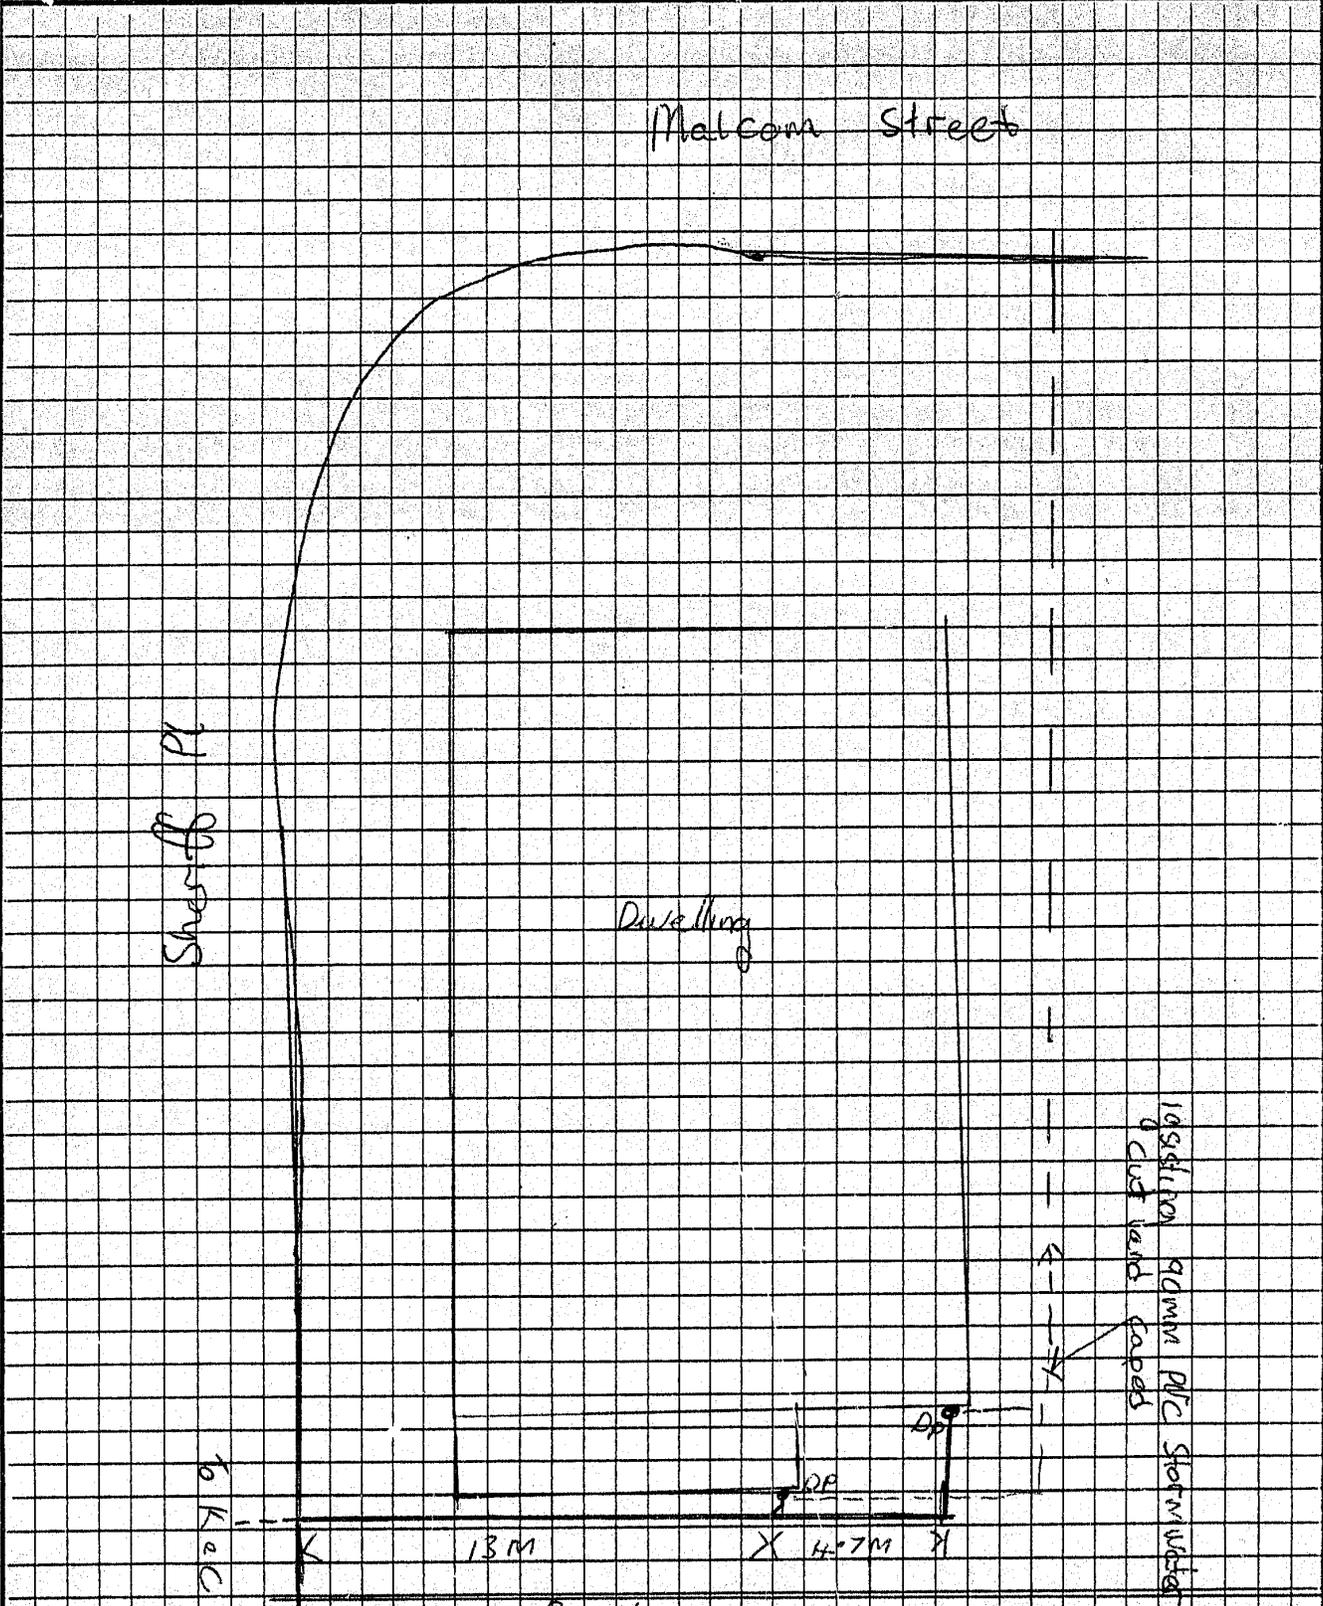

Not to Scale. All measurements to be shown.