


**BUILDING UNIT
 AS LAID DRAINAGE PLAN**

LOT: DPS	OWNER: CJC Holdings Ltd	STREET: Kilauea Rd.	NO: 241
DRAINLAYER: D.B. Robinson	INSPECTOR: Gerard	DATE OF INSPECTION: 9-17/10/06	
REG No: 14754	CONSENT No:		

DRAINLAYER PLEASE FILL IN ALL DETAILS

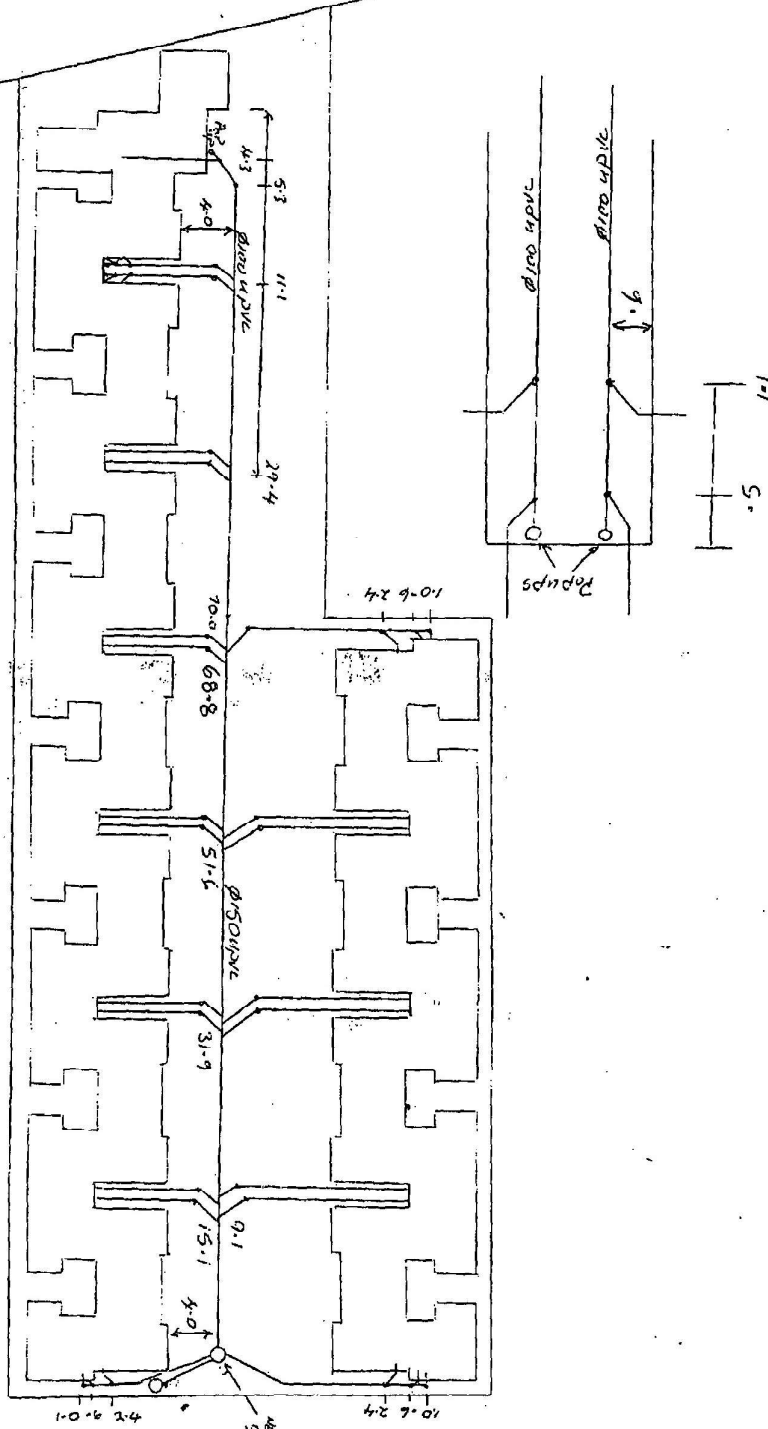

AS Laid SEWER PLANS KILMARNEY ROAD
 WPS

D.B. Robinson
 REG No: 14754