



Hamilton City Council

Te kaunihera o Kirikiriroa

Private Bag 3010, Hamilton, New Zealand.

FAX: (07) 838 6684

BUILDING UNIT

AS LAID DRAINAGE PLAN

STREET: Merlot

No: 15

LOT: 11

DPS

OWNER: M. Reynolds

DRAINLAYER: B D Gleeson


INSPECTOR:

REG No: 11305

DATE OF INSPECTION: 28 . 8 . 02

CONSENT No: 1327/2002

DRAINLAYER PLEASE FILL IN ALL DETAILS

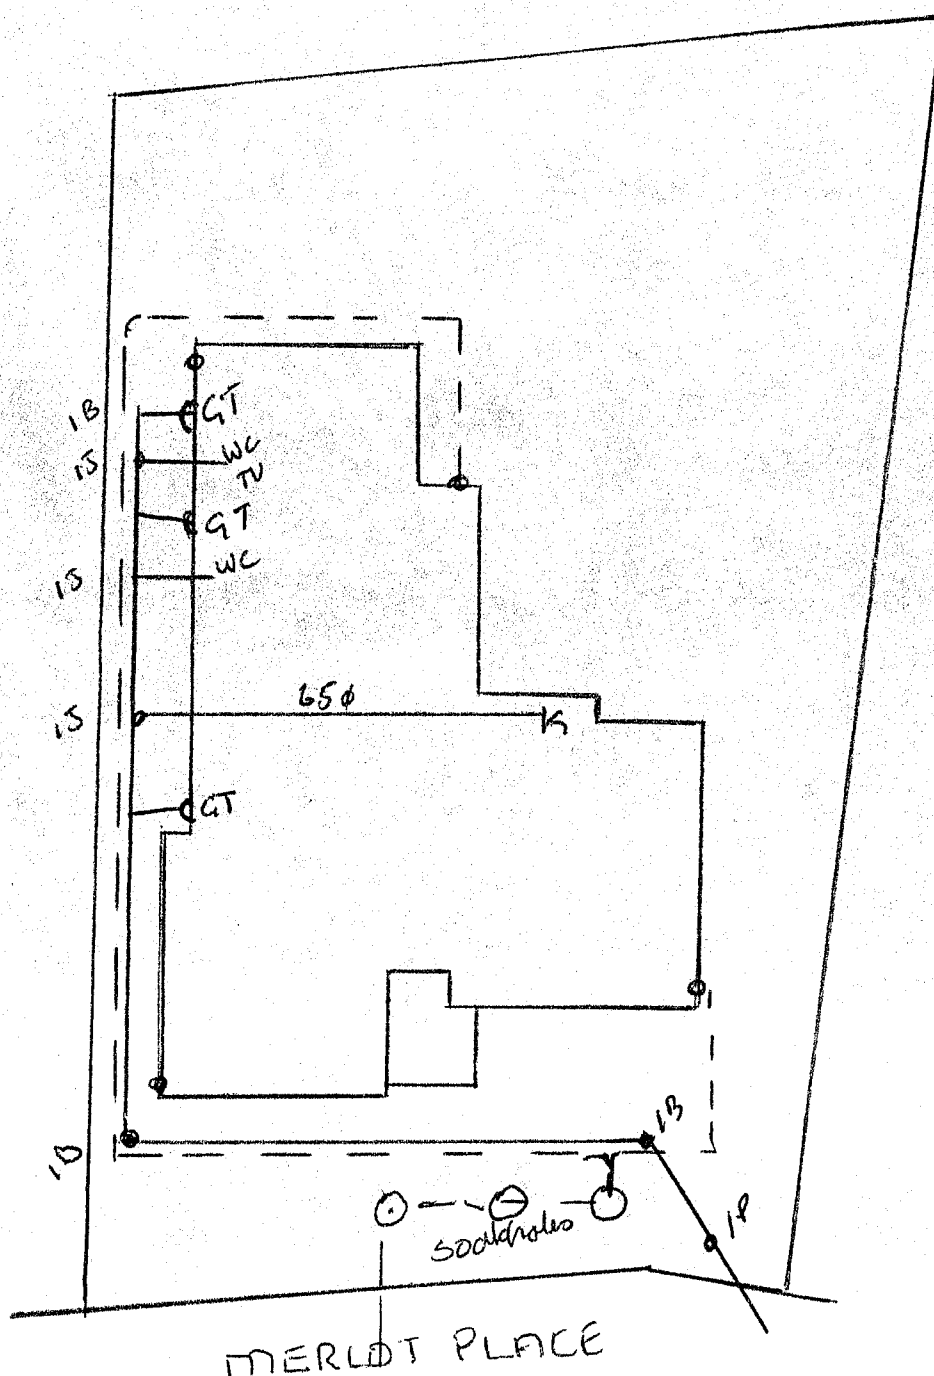

DRAINLAYER'S SIGNATURE:

DATE: 28 . 8 . 02

ALDP version 1 04/2002