



## As Laid Drainage

Working Together

Building Consent Number: 2019 39084

Date: 1 / 12 / 19 No. of pages:

Building Address: 1 Bosun Place, Flagstaff, Hamilton (132 Tehina Dr)

Drain Layer Name: John Vorgers

[Please print clearly]

Signature:


*J Vorgers*

Registration Number: 10688

Business Name: Thomas Curle Plumbing Ltd

To Council: [Tick]

☒ Hamilton ☐ Hauraki ☐ Matamata-Piako ☐ Otorohanga ☐ Thames-Coromandel ☐ Waipa ☐ Waikato ☐ Waitomo

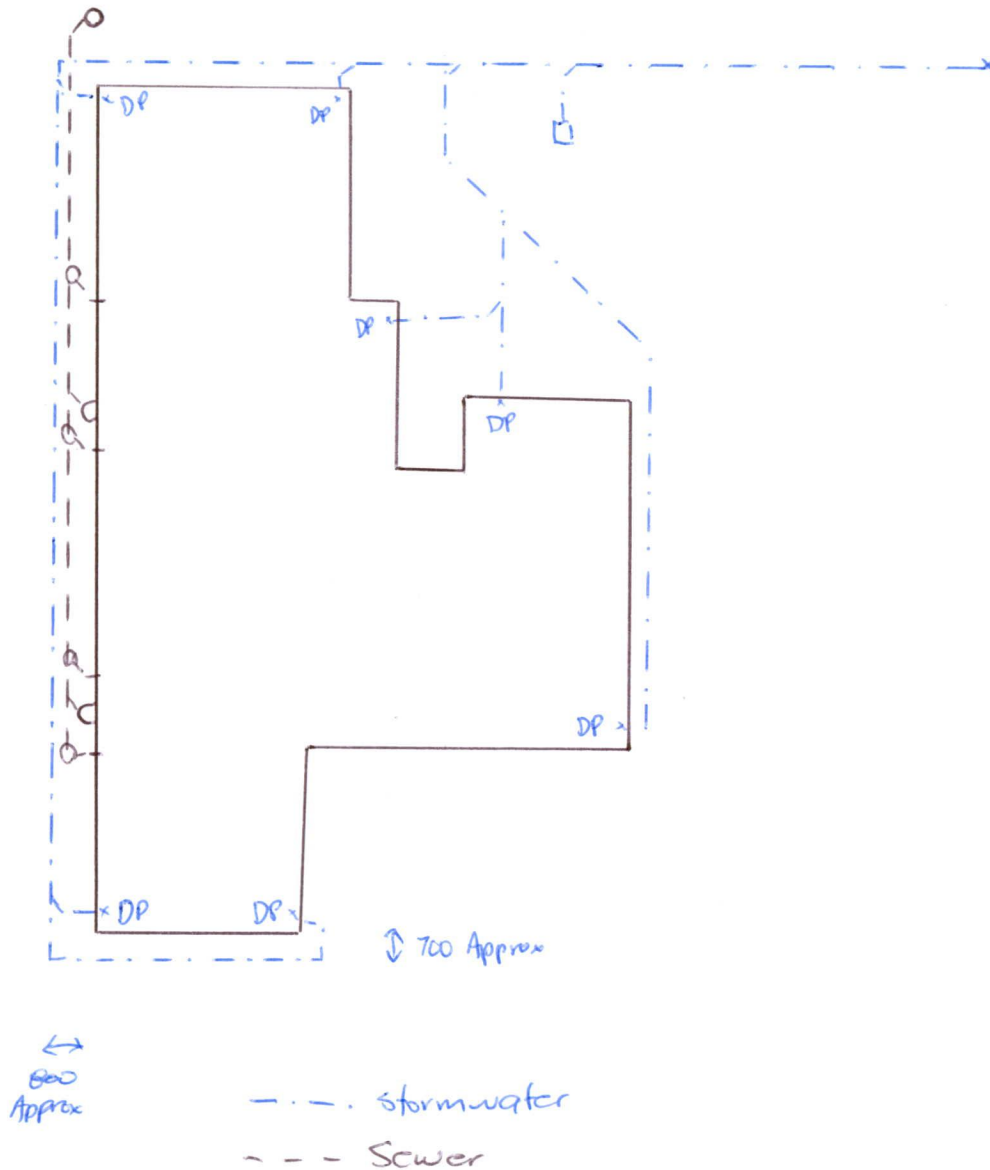

12 Plugs

2 25 crimp caps

2 20 crimp caps