



Hamilton City Council

Te kaunihera o Kirikiriroa

Private Bag 3010, Hamilton, New Zealand.

FAX: (07) 838 6684

BUILDING UNIT

AS LAID DRAINAGE PLAN

STREET: Palm Grove **No:** _____

OWNER: Gillett Construction

INSPECTOR: John

DATE OF INSPECTION: 29.10.03


LOT: 14 **DPS** _____

DRAINLAYER: B Dave

REG No: 09502

CONSENT No: _____

DRAINLAYER PLEASE FILL IN ALL DETAILS

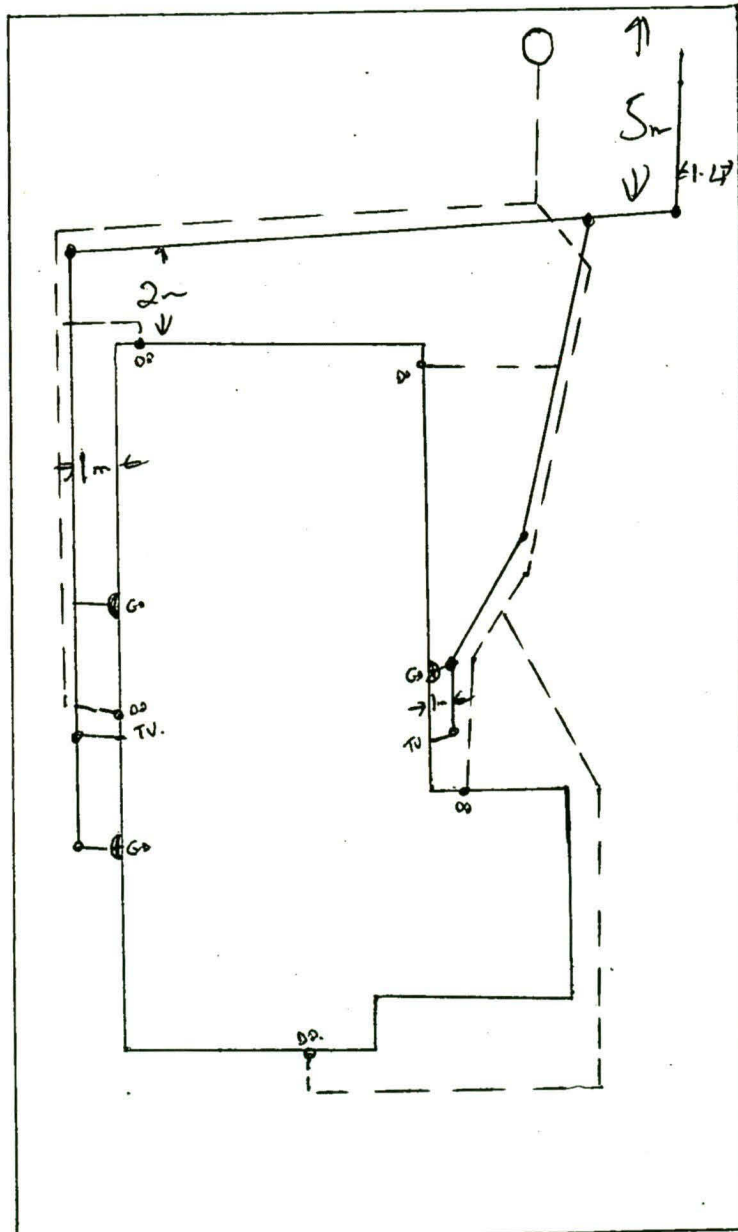

DRAINLAYER'S SIGNATURE: _____

B Dave

DATE: 29.10.03