

# CITY OF HAMILTON PROPERTY SERVICES GROUP

---

DRAINAGE PLAN FOR:

6 ~~BALMORNO~~ <sup>CS</sup> STREET LOT 93 D.P. 54572  
OWNER Reed built. ADDRESS .....

TYPE OF BUILDING New Dwelling

DRAINLAYER W. Potts

ADDRESS 19 Rosefield Drive  
Hamilton

DATE OF INSPECTION 27. 2. 91

INSPECTOR [Signature]

DRAINAGE PERMIT No. 91/01/0058

BUILDING PERMIT No. 90/2477


DRAINLAYER'S SIGNATURE [Signature]

**NOTE:** Plan to be drawn in black ballpoint on graph opposite.

---

## PLAN TO INCLUDE:

1. The correct position of the drains in relation to the building and boundaries.
2. The position of the street frontage.
3. Depth of drains at connection point.
4. Both foulwater and stormwater drains to be drawn.
5. Drawn to a scale 1-200.
6. One square equals 1 metre.
7. See example drain plan overleaf.

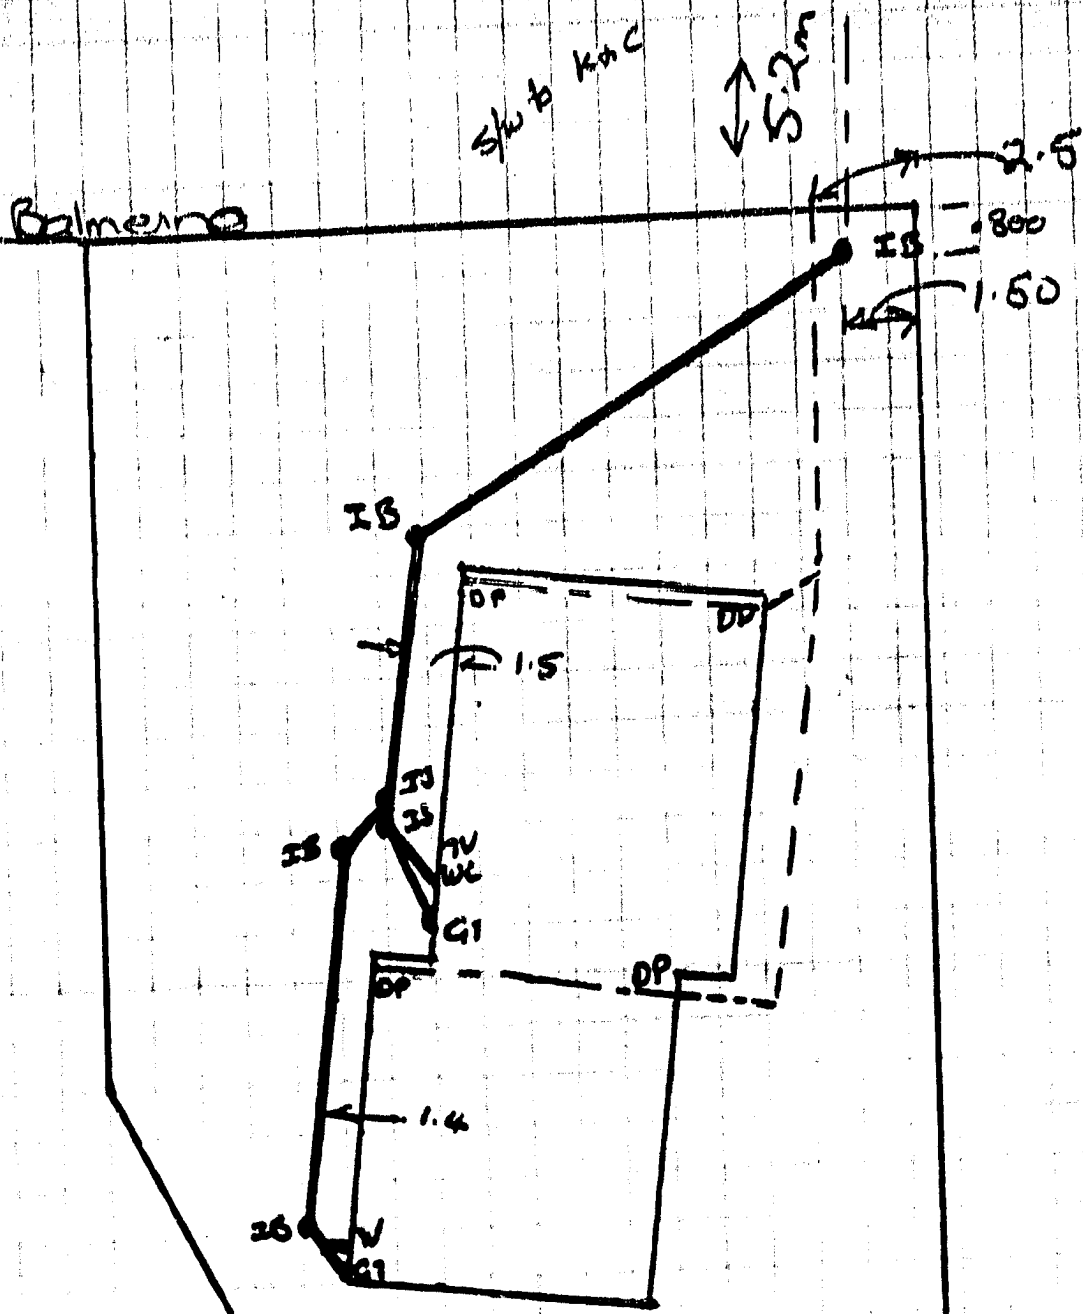

lot 93  
 D.P.S 64572