




As Laid Drainage


Working Together

Building Consent Number: 2021/42396 Date: 10 / 5 / 21 No. of pages: 1
Building Address: 20 Parser Cres, Hamilton
Drain Layer Name: Allister Shepherd. [Please print clearly] Signature: *A Shepherd*
Registration Number: 21608 Business Name: Titan Drainage Ltd
To Council: [Tick]
☒ Hamilton ☐ Hauraki ☐ Matamata-Piako ☐ Otorohanga ☐ Thames-Coromandel ☐ Waipa ☐ Waikato ☐ Waitomo

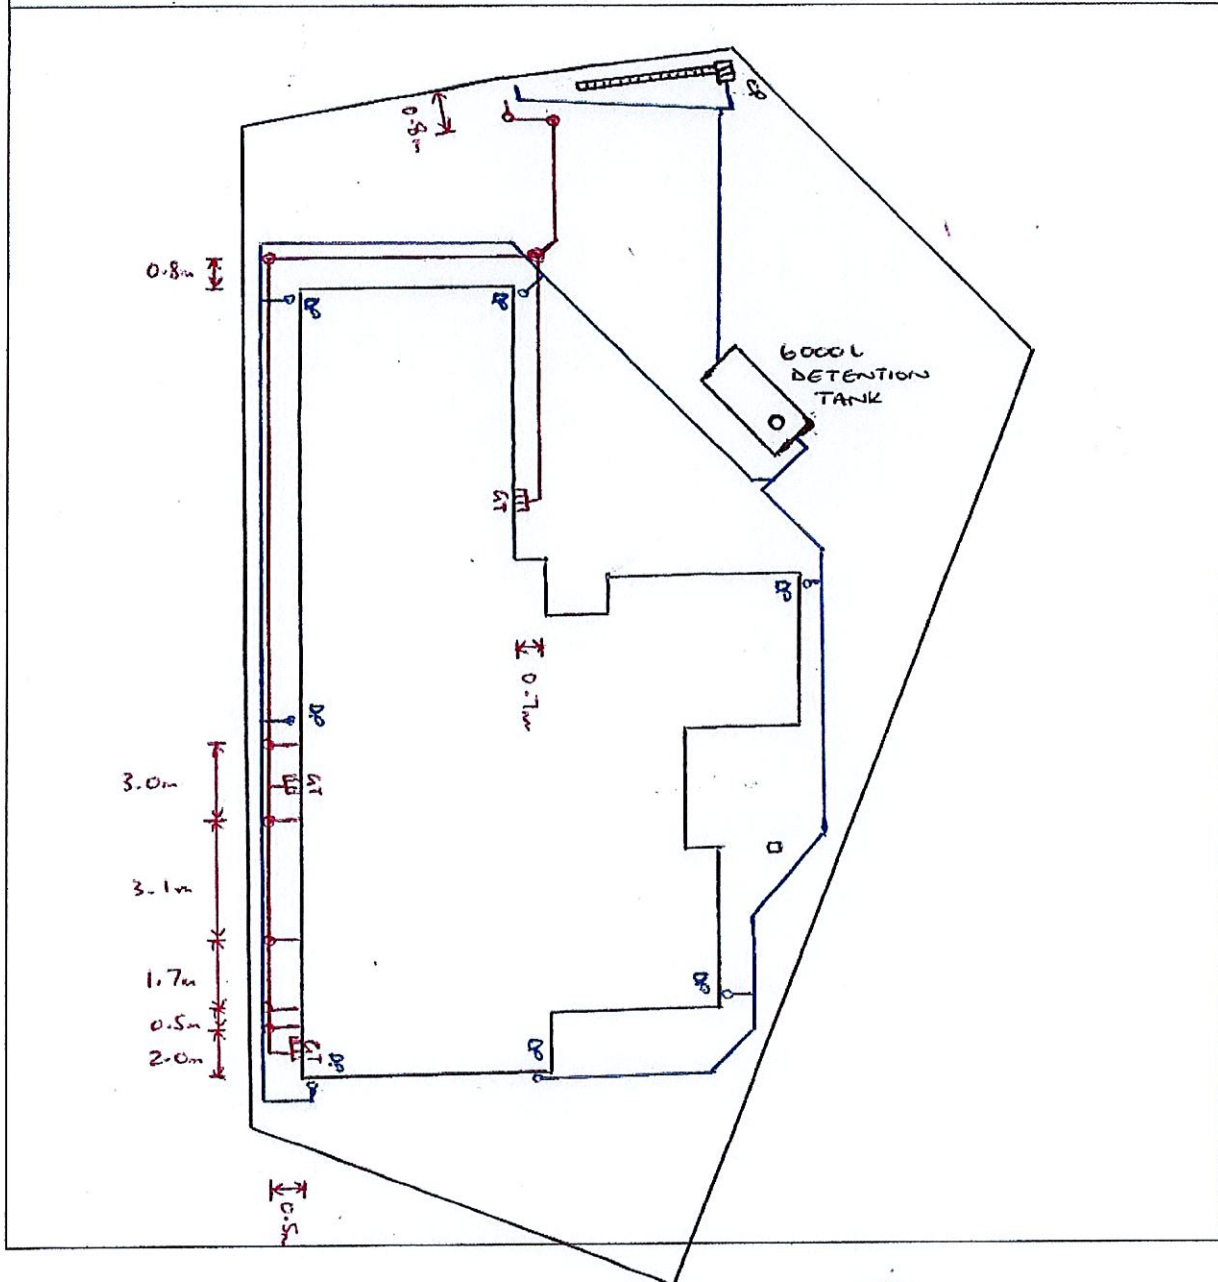

NOTE:


1. This drawing is reproduced from the Site Plan prepared by DOWNEY designer HOMES Ltd.
2. All areas and distances where shown are subject to survey.

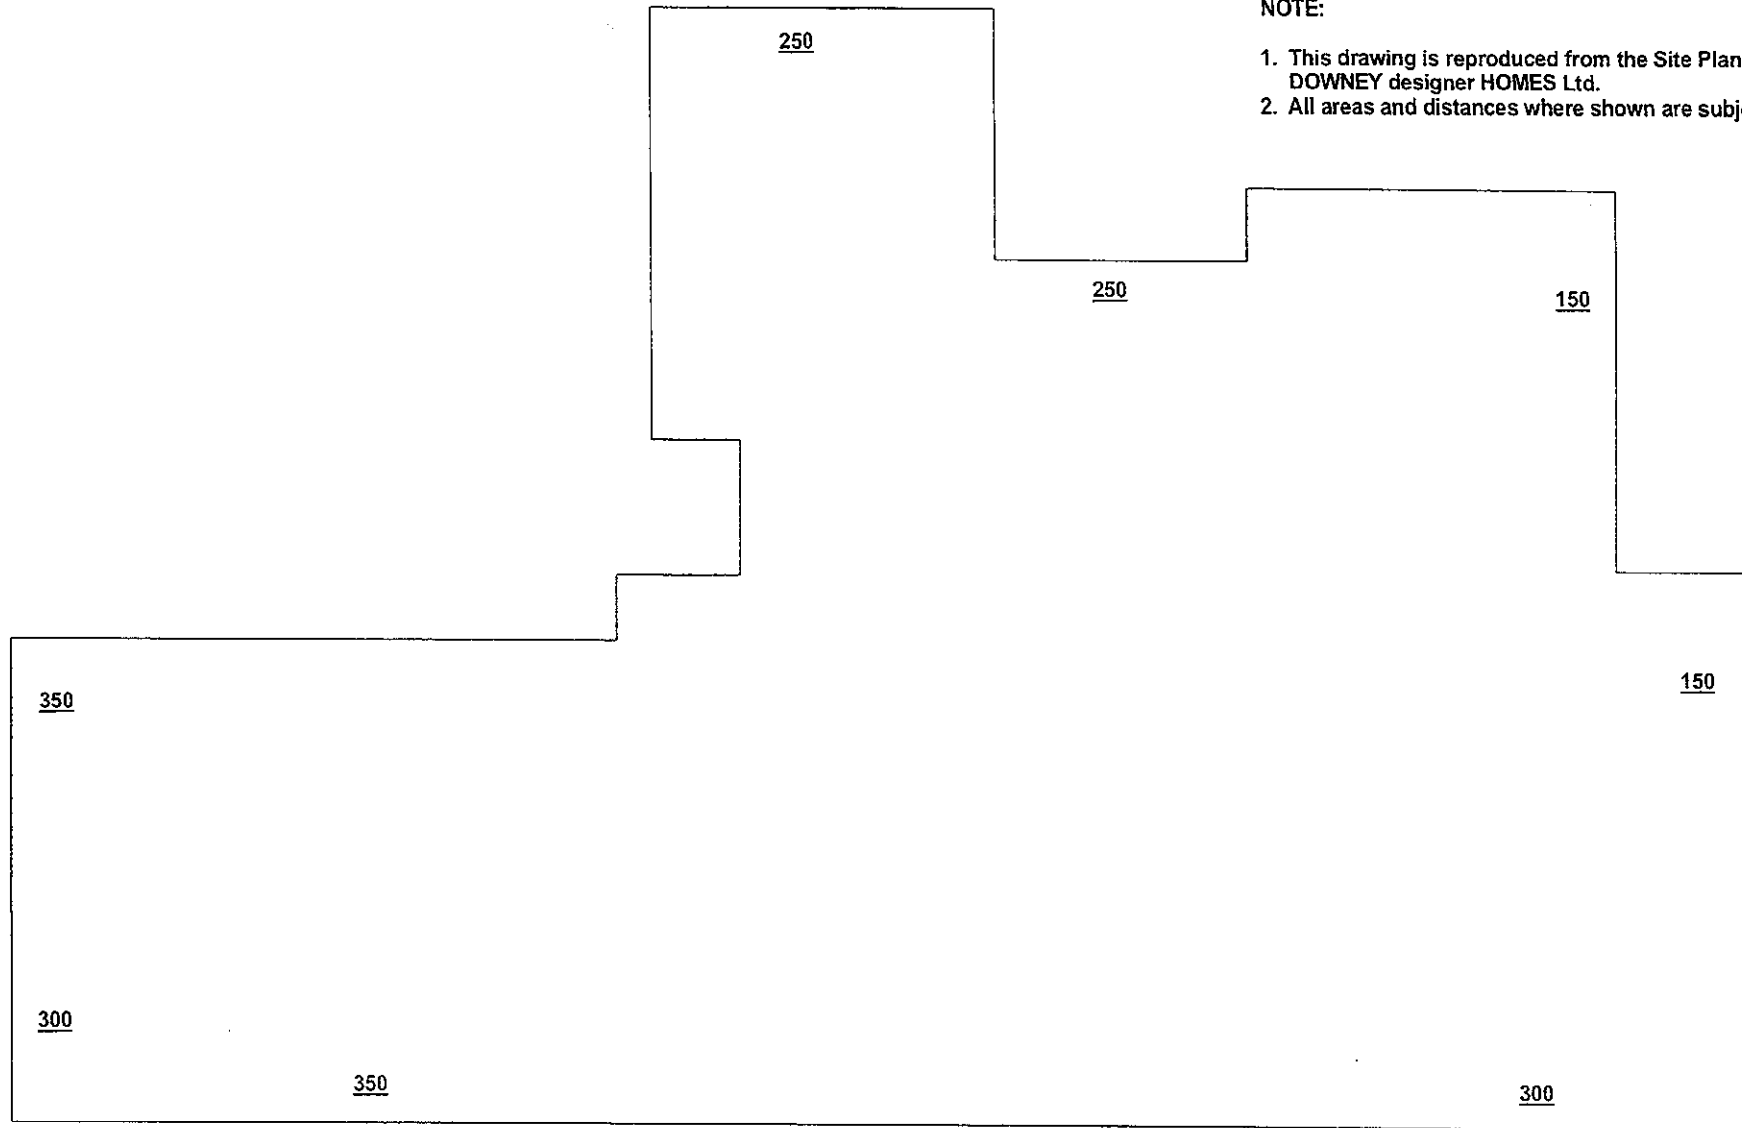

LEGEND

300 denotes depth of excavation (mm) below the underside of floor slab

SCALE 1:100

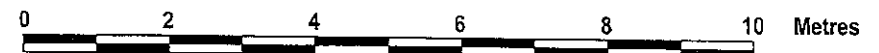

Mark T Mitchell Ltd

Geotechnical Engineers

1150 Victoria Street, P.O. Box 9123, Hamilton

DOWNEY DESIGNER HOMES LTD

Proposed Dwelling

No. 20 (Lot 60) Purser Crescent, Hamilton

SITE PLAN - AS BUILT

DRAWING No. 16626-01

DATE April 2021

ISSUE DATE 23.04.2021