

410833

BCP-009

Issue 1
Page 1 of 1

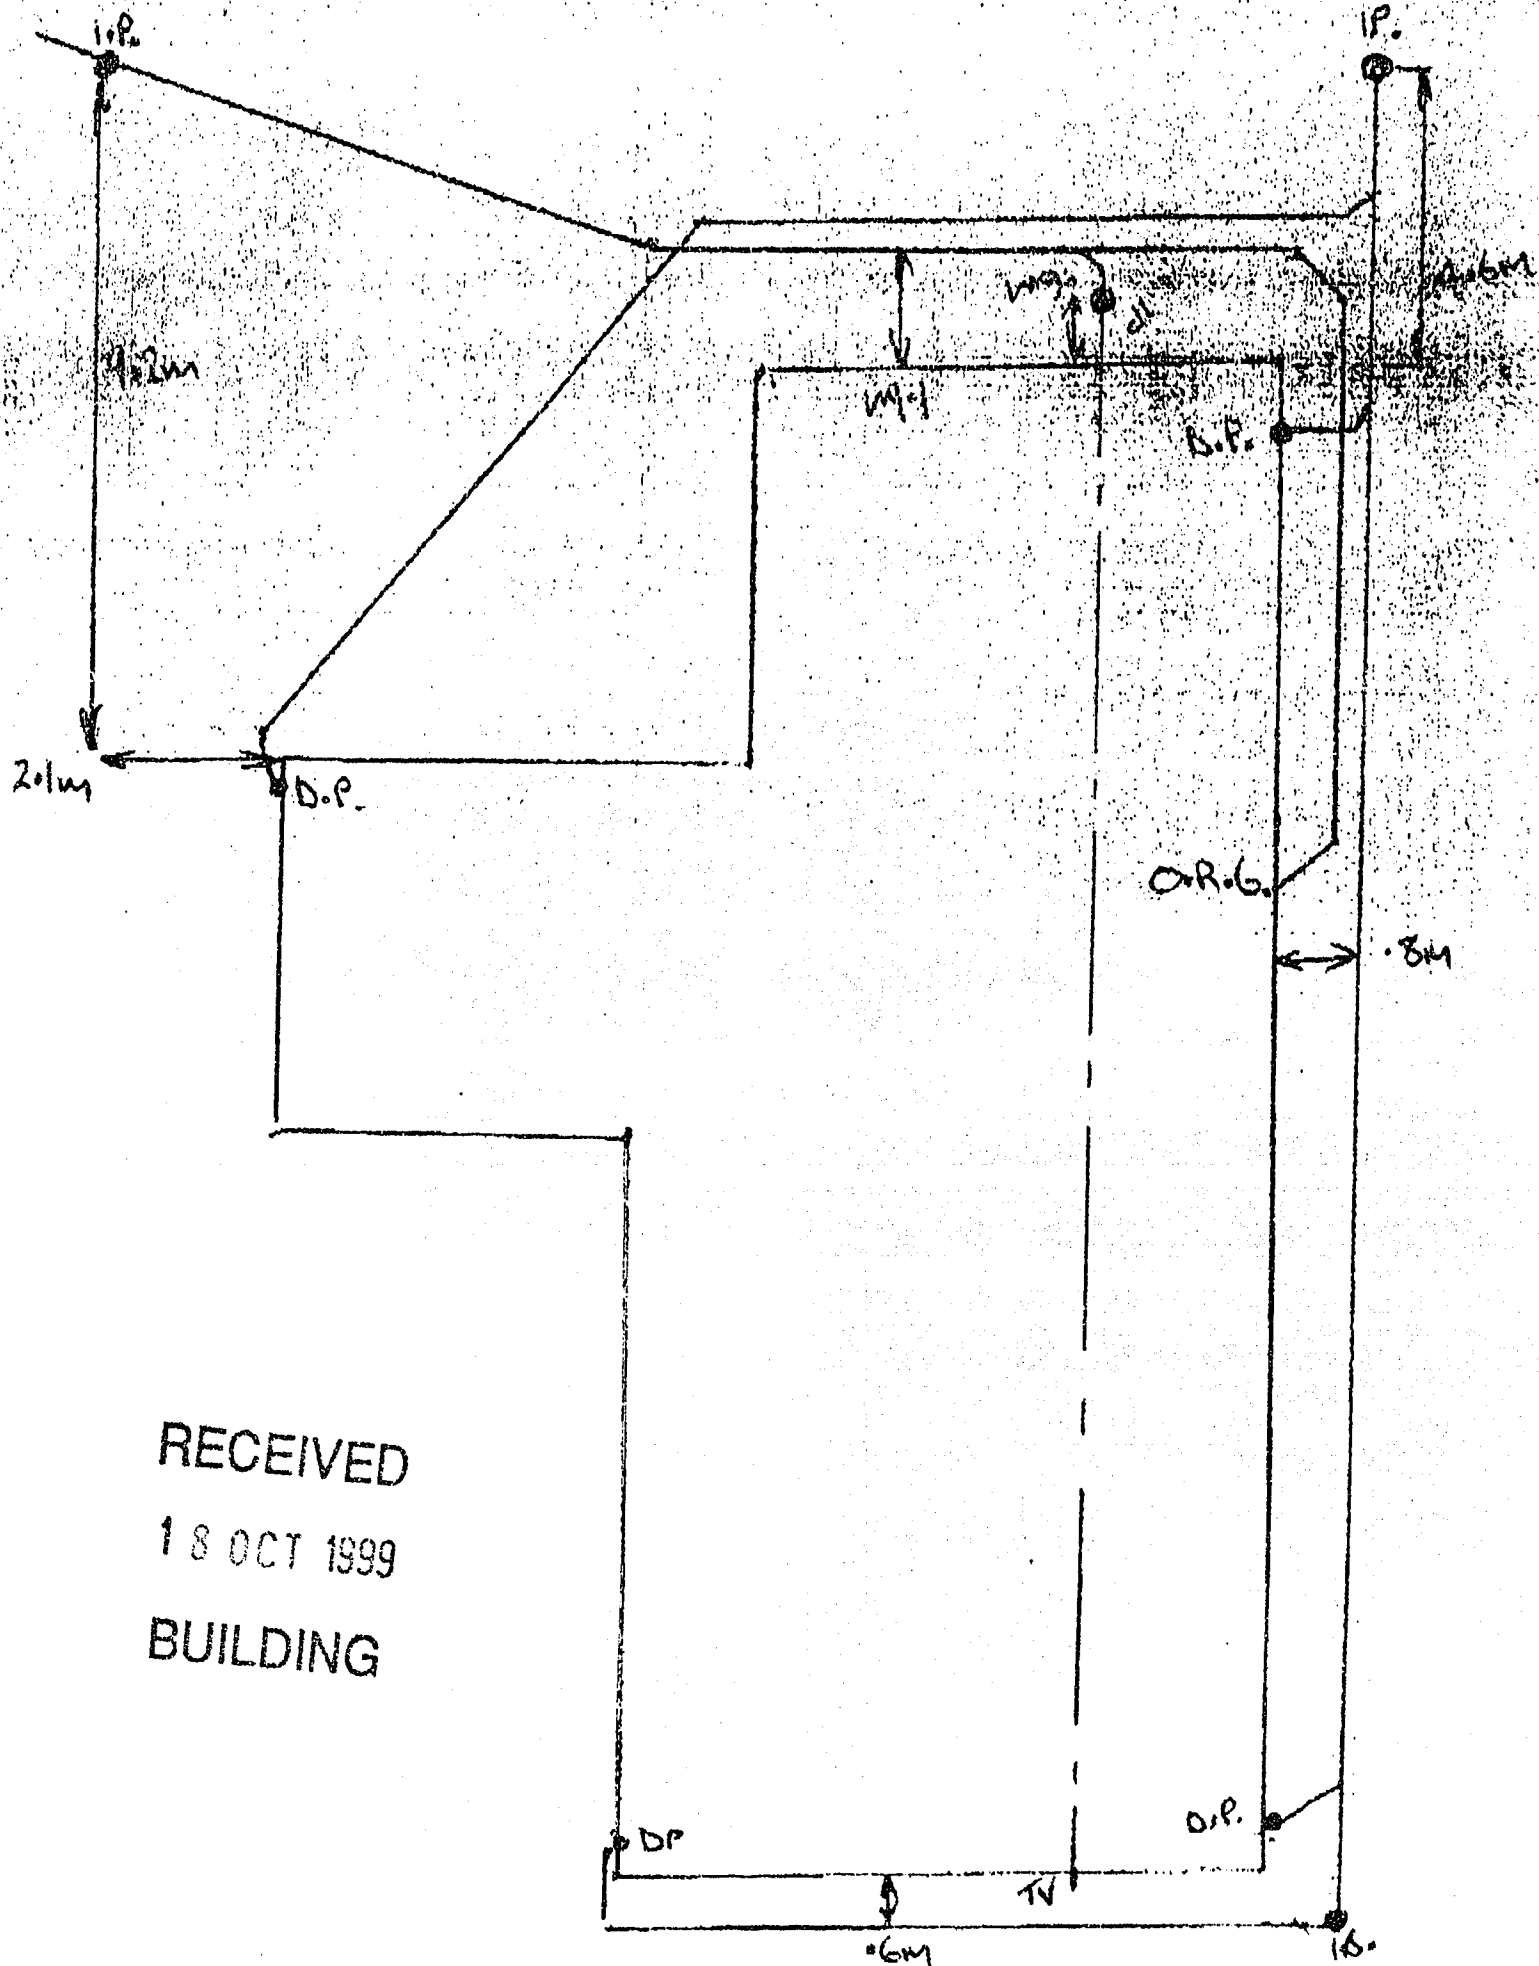
CITY OF MANUKAU - DRAINAGE PLAN

Street code:

LOT: 90 DP: STREET NO: Belong WARD

OWNER: DRAINLAYER: Graham Anderson

NOTE: Please provide figured measurements from a defined point of reference, in black ink

RECEIVED
18 OCT 1999
BUILDING