

AS LAID

S 13 ✓  
101



## HAMILTON CITY

OFFICE OF THE CHIEF BUILDING INSPECTOR,  
BARTON STREET,  
PRIVATE BAG, HAMILTON, N.Z.  
PHONE 81 919

RECEIVED

1 - DEC 1983

BLDG. DIV.

### APPLICATION FOR PERMIT FOR SANITARY, PLUMBING AND DRAINAGE WORK

I, the undersigned (name in full) Wallace John Pitts address 19 Morefield Drive

Hereby make application for permission to carry out the work prescribed herein, as set out in the plans attached hereto, at the premises situated in:-

136 Dunsdale Rd Street/Road, being Lot 12 D.P.S. 26179

Name and Address of owner of premises: Gallagher

Nature of Work Sanitary & Stormwater Drainage - New Dwelling

Value of proposed work excluding materials \$ c

(a) Plumbing

(b) Drainage (including stormwater)

..... Regd. No. .... Licensed Plumber

W. J. Pitts ..... Regd. No. 5281 ..... Licensed Drainlayer

Dated this ..... day of ..... 19.....


Building Permit 25072 12-9-83 Drainage Permit 022079 Plumbing Permit 021761

Plumbing & Drainage Costs \$1300-00 Plumbing & Drainage Fees \$93-00

Details of drainage and boundaries required overleaf.

STREET Dinsdale Rd.

0 5 10 15 20 25

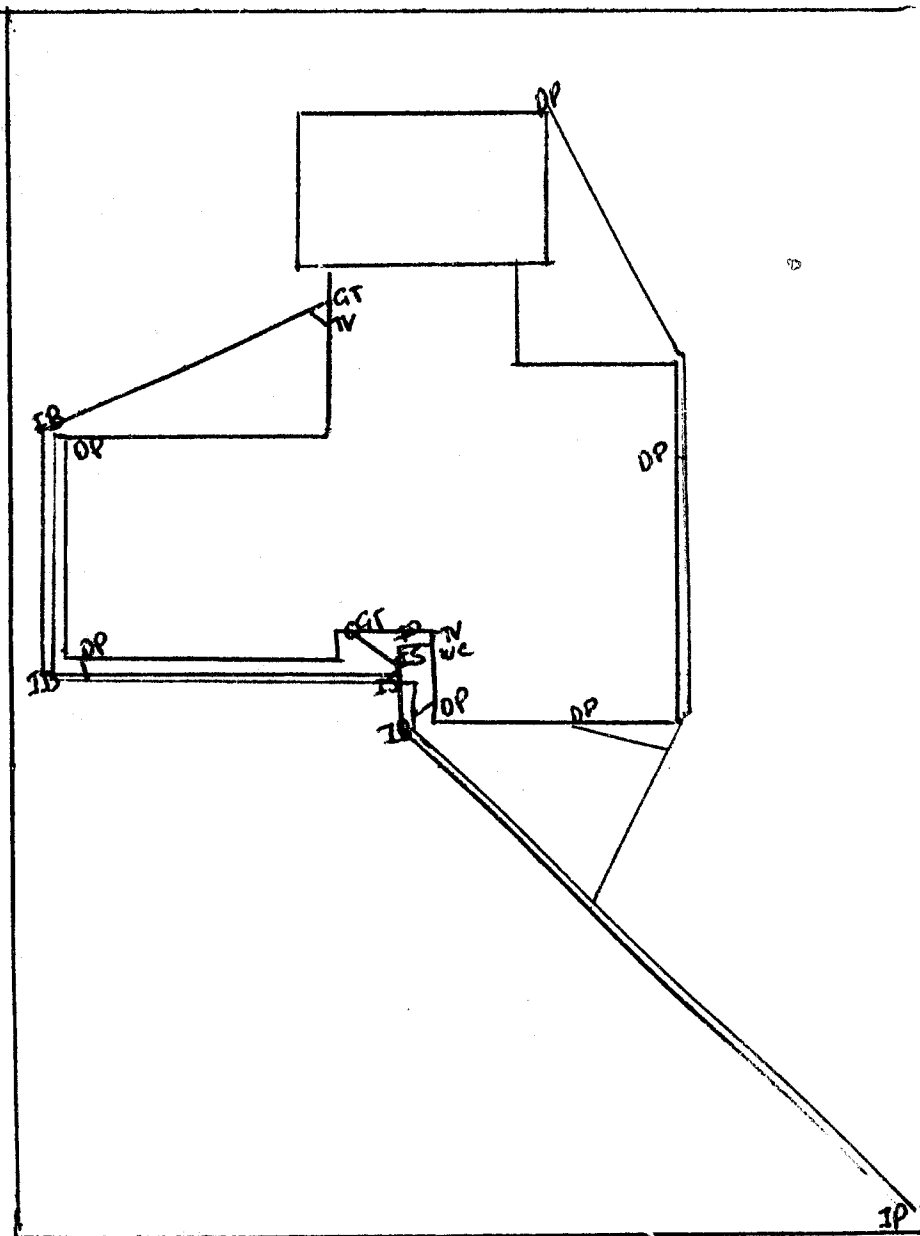

Date of Inspection .....

Drainlayer's Signature .....

*AMB Ryan*