

STREET: McClaren / Chedworth **No:** 12

LOT: 16 **DPS** 15701

OWNER: Jason

DRAINLAYER: Bruce Underwood


INSPECTOR: Andrew McLabe

REG No: 15346

DATE OF INSPECTION: 15/5/14

CONSENT No: 2013/30211

DRAINLAYER PLEASE FILL IN ALL DETAILS

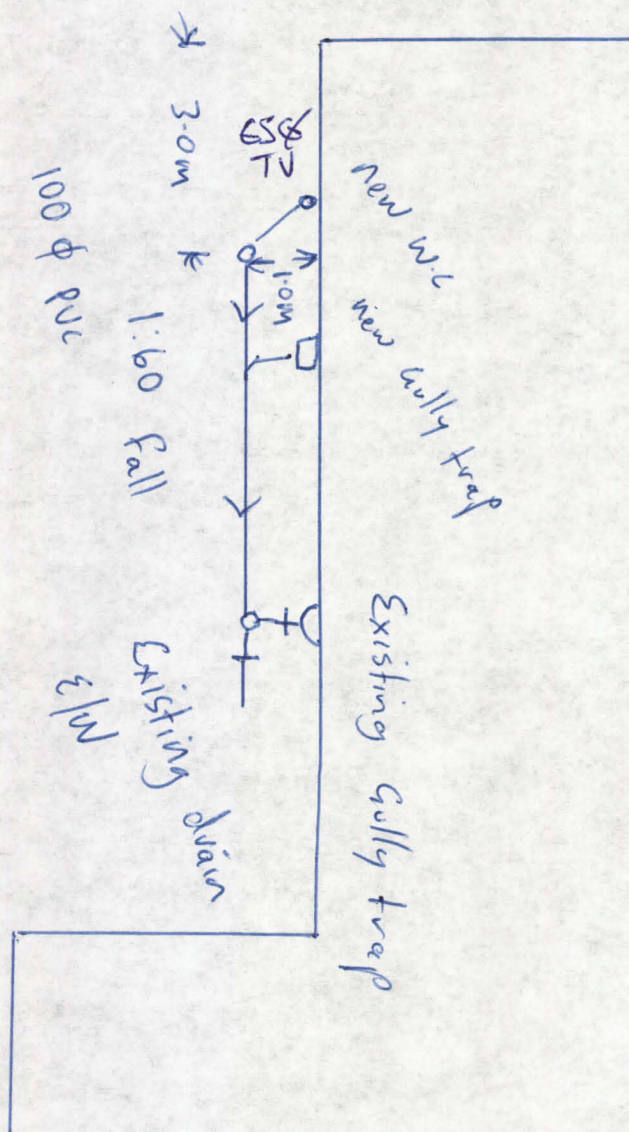

DRAINLAYER'S SIGNATURE:

Bell

DATE:

15/5/14