


BUILDING UNIT AS LAID DRAINAGE PLAN

STREET: <u>BANKWOOD RD</u> No: <u>245</u>	LOT: <u>DPS</u>
OWNER: <u>ANN MONTAGAN</u>	DRAINLAYER: <u>NATHAN HOYLE</u>
INSPECTOR: <u>JOHN MATHEW</u>	REG No: <u>11646</u>
DATE OF INSPECTION: <u>18-10-06</u>	CONSENT No: <u>2005 / 14314</u>


DRAINLAYER PLEASE FILL IN ALL DETAILS

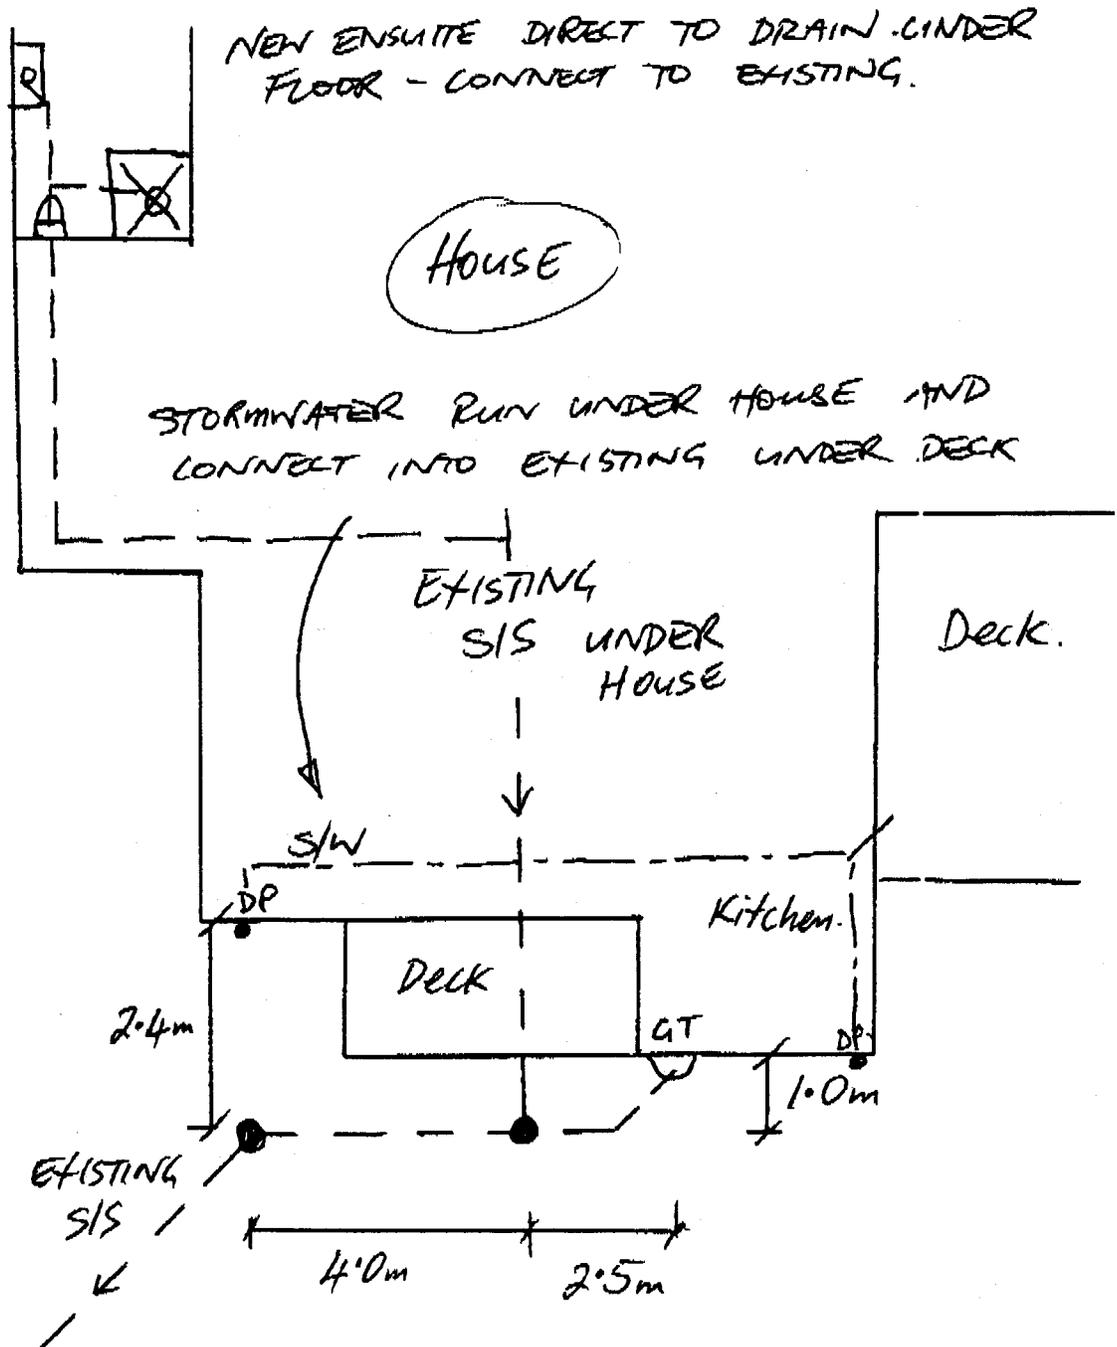

BUILDING UNIT AS LAID DRAINAGE PLAN

STREET: <u>BANKWOOD RD</u> No: <u>245</u>	LOT: <u>DPS</u>
OWNER: <u>ANN MONTAGAN</u>	DRAINLAYER: <u>NATHAN HOYLE</u>
INSPECTOR: <u>JOHN MATHEW</u>	REG No: <u>11646</u>
DATE OF INSPECTION: <u>18-10-06</u>	CONSENT No: <u>2005 / 14314</u>

DRAINLAYER PLEASE FILL IN ALL DETAILS

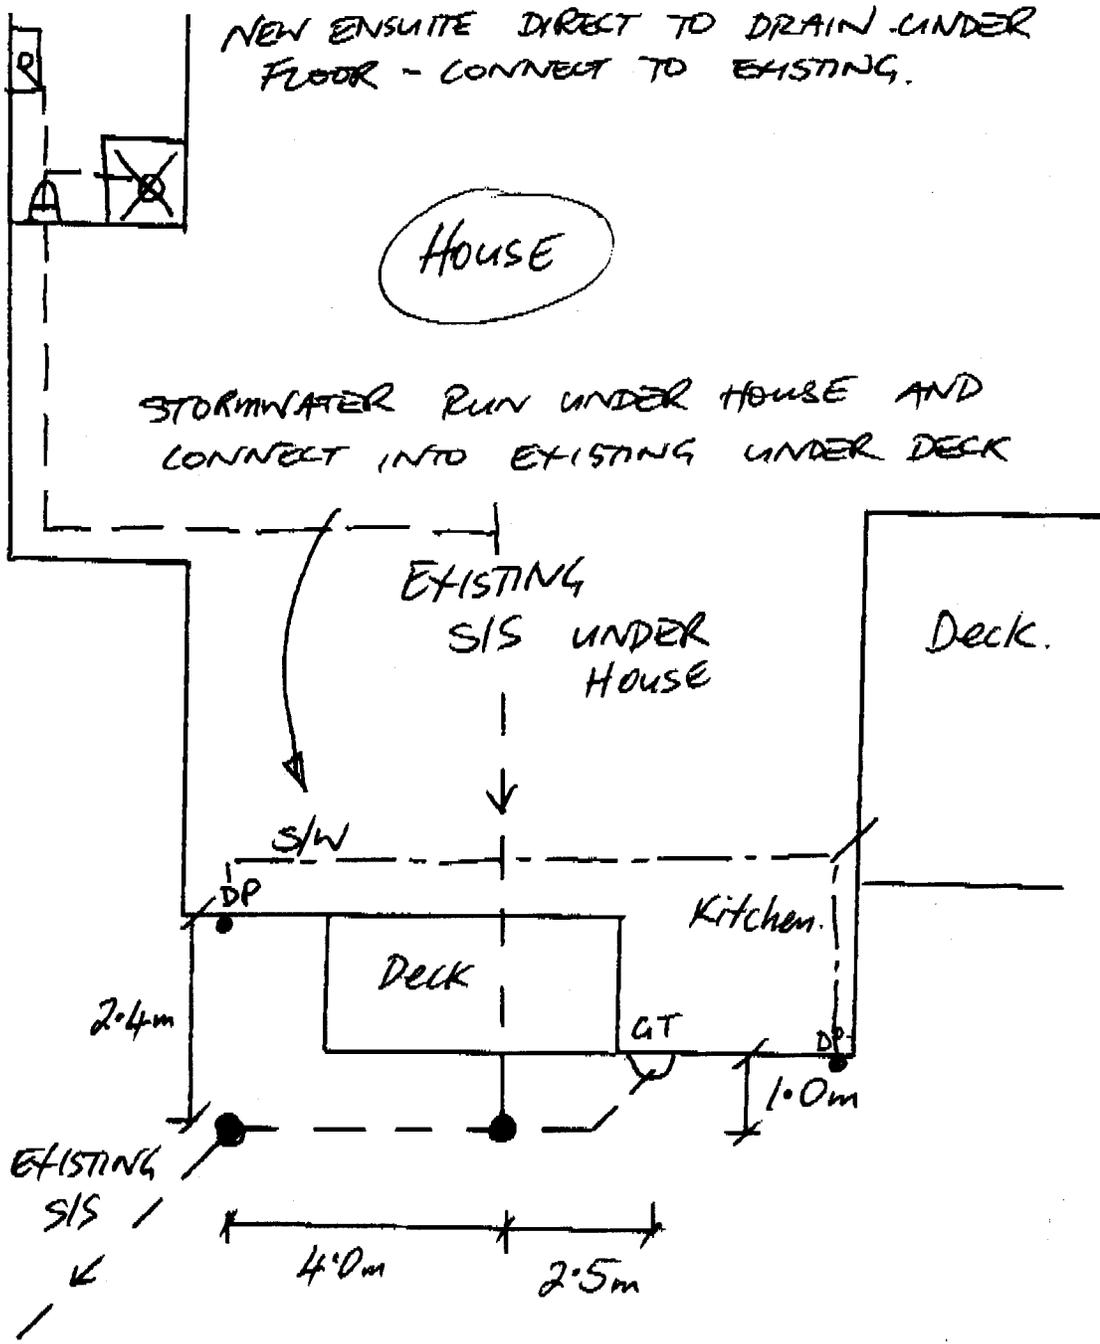

DRAINLAYER'S SIGNATURE: Nathan Hoyle DATE: 18-10-06