


BUILDING UNIT AS LAID DRAINAGE PLAN

STREET: <u>Trinidad Place</u> No: _____	LOT: <u>51</u> DPS _____
OWNER: <u>Aspect Homes</u>	DRAINLAYER: <u>R Dave</u>
INSPECTOR: <u>John</u>	REG No: <u>09502</u>
DATE OF INSPECTION: <u>18.09.07</u>	CONSENT No: _____

DRAINLAYER PLEASE FILL IN ALL DETAILS

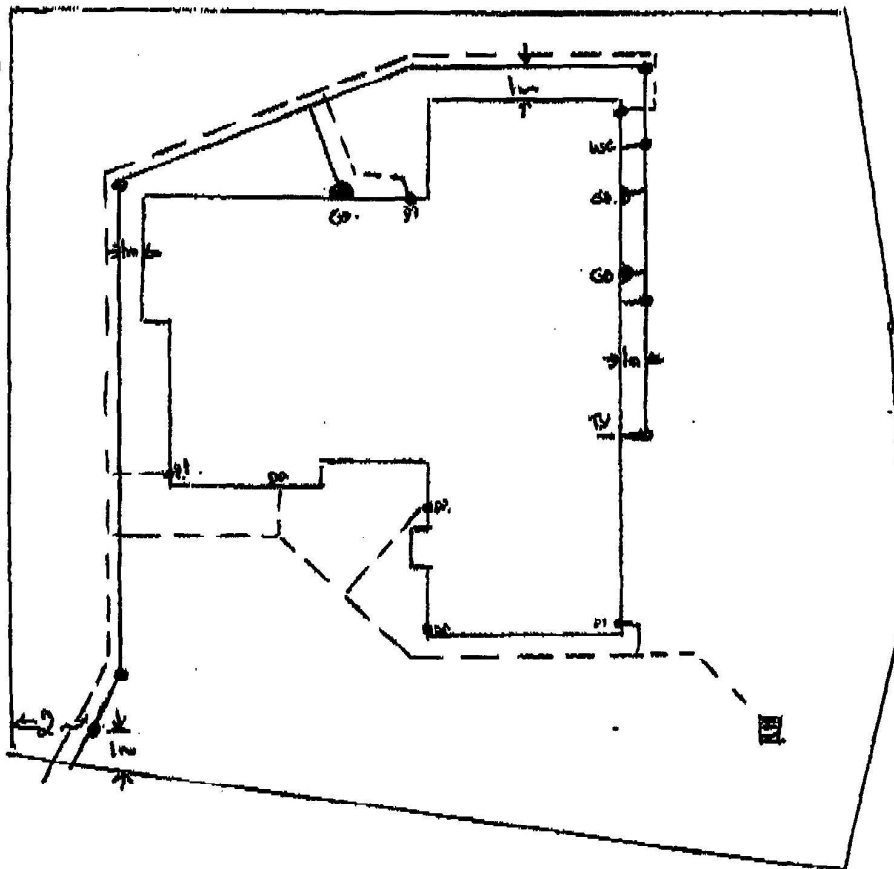

ATTENTION LES

FROM DAVE MILLAR (ASPECT HOMES)

DRAINLAYER'S SIGNATURE: _____

DATE: _____