


AS LAID DRAINAGE PLAN

STREET: <u>Hukaruni Rd.</u>	No: _____	LOT: <u>6</u>	DPS
OWNER: _____		DRAINLAYER: <u>Graham McDermott</u>	
INSPECTOR: _____		REG No: <u>12969</u>	
DATE OF INSPECTION: _____		CONSENT No: _____	

DRAINLAYER PLEASE FILL IN ALL DETAILS

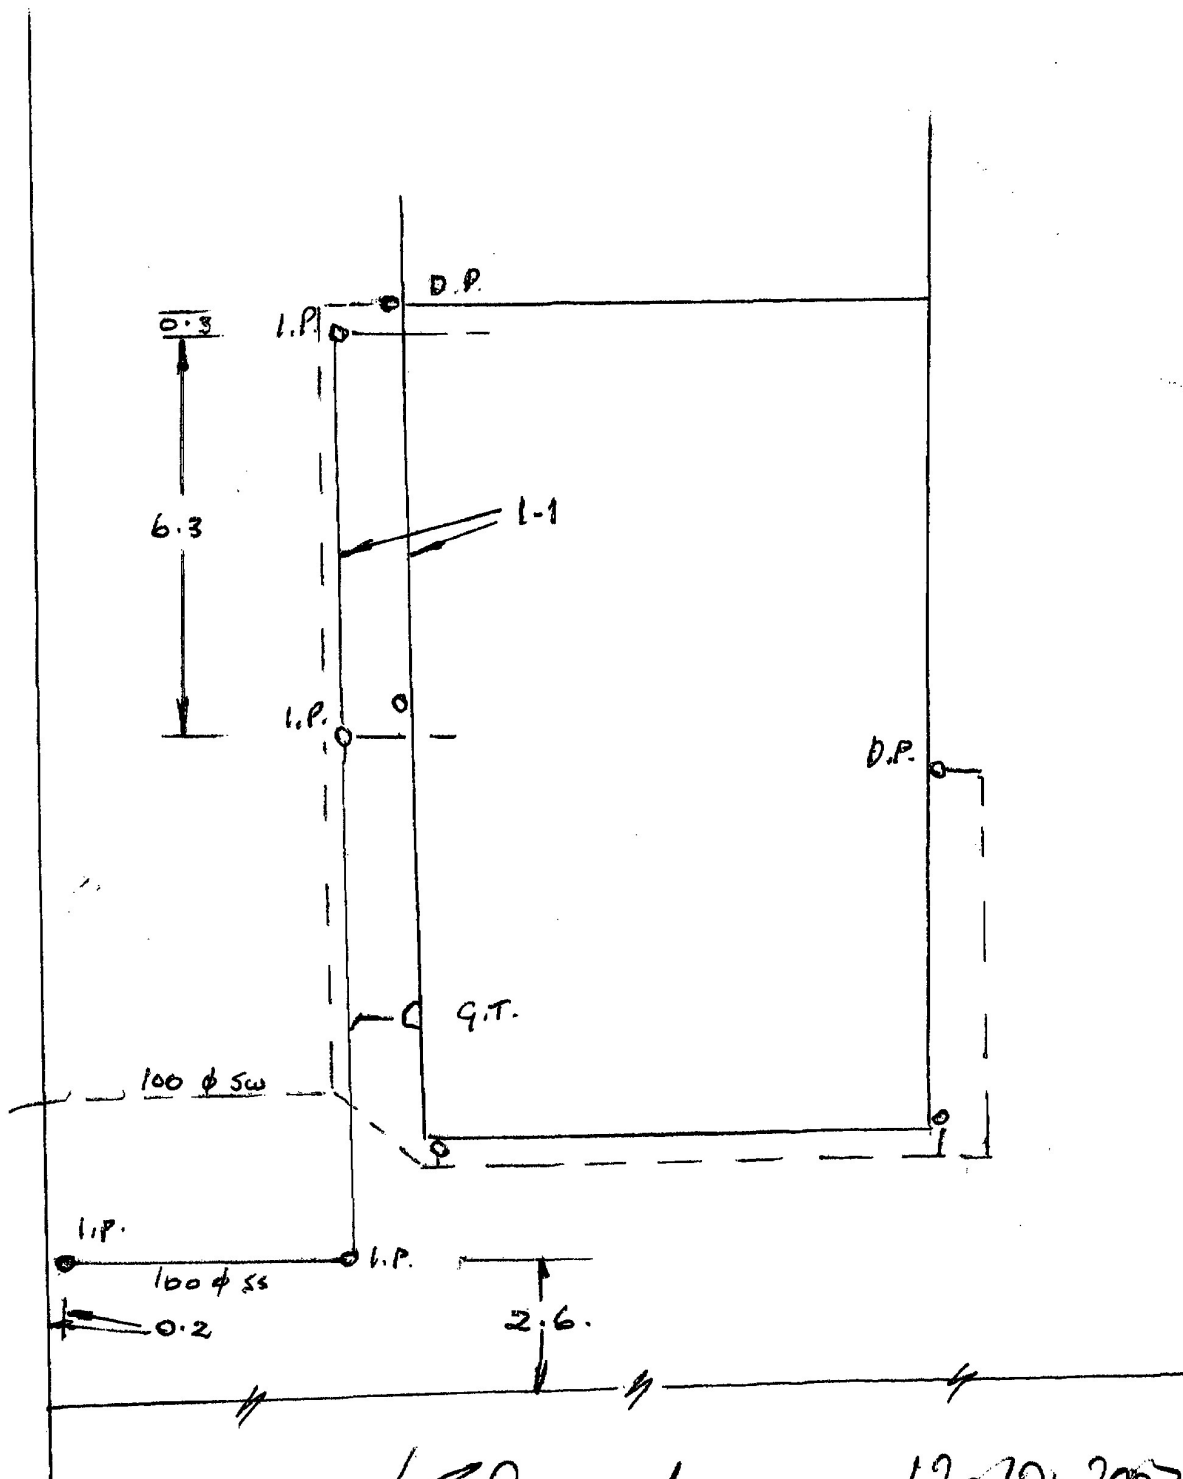

DRAINLAYER'S SIGNATURE:

Graham McDermott


DATE:

12.10.2007

BUILDING UNIT AS LAID DRAINAGE PLAN

STREET: <u>Hukanui Rd.</u> No: _____	LOT: <u>3</u> DPS <u>65422</u>
OWNER: _____	DRAINLAYER: <u>Graham Dwyer</u>
INSPECTOR: _____	REG No: <u>12919</u>
DATE OF INSPECTION: _____	CONSENT No: _____

DRAINLAYER PLEASE FILL IN ALL DETAILS

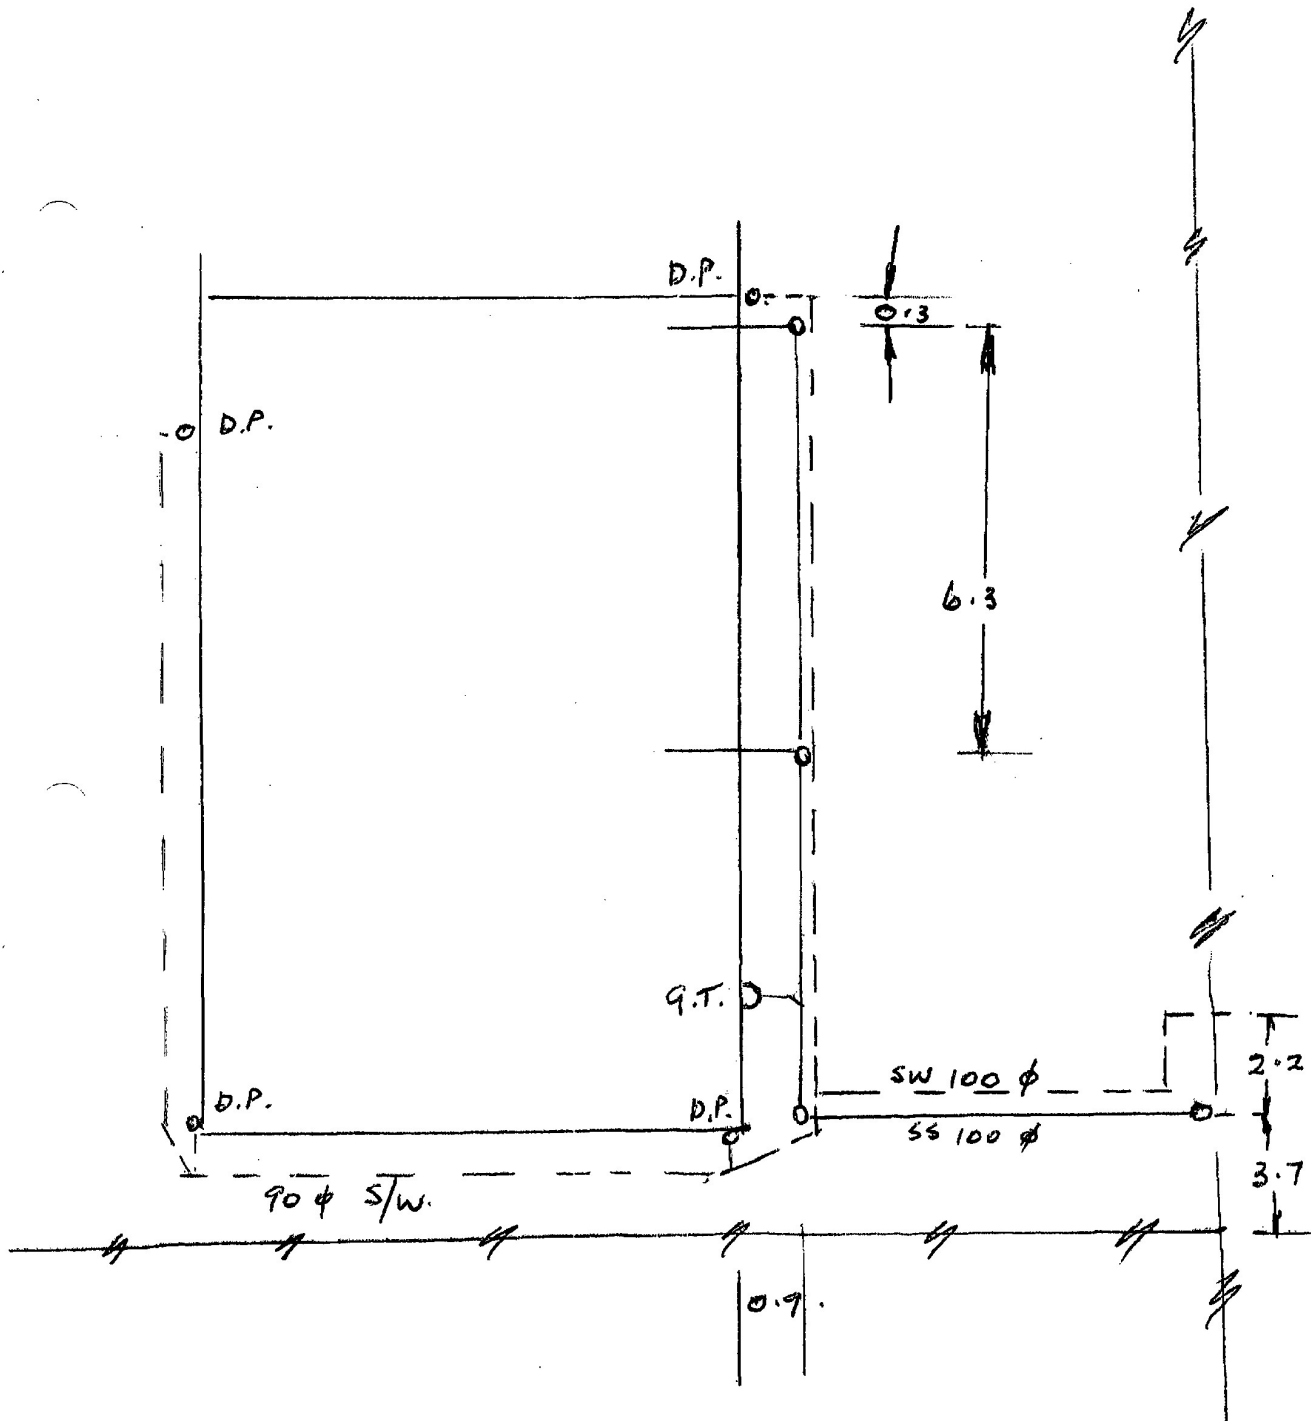

DRAINLAYER'S SIGNATURE:

Graham Dwyer


DATE:

12/10/2007

BUILDING UN
AS LAID DRAINAGE PLAN

STREET: <u>Hukarui Rd.</u> No: _____	LOT: <u>#5</u> DPS _____
OWNER: _____	DRAINLAYER: <u>Graham Dwyer</u>
INSPECTOR: _____	REG No: <u>112 919</u>
DATE OF INSPECTION: _____	CONSENT No: _____

DRAINLAYER PLEASE FILL IN ALL DETAILS

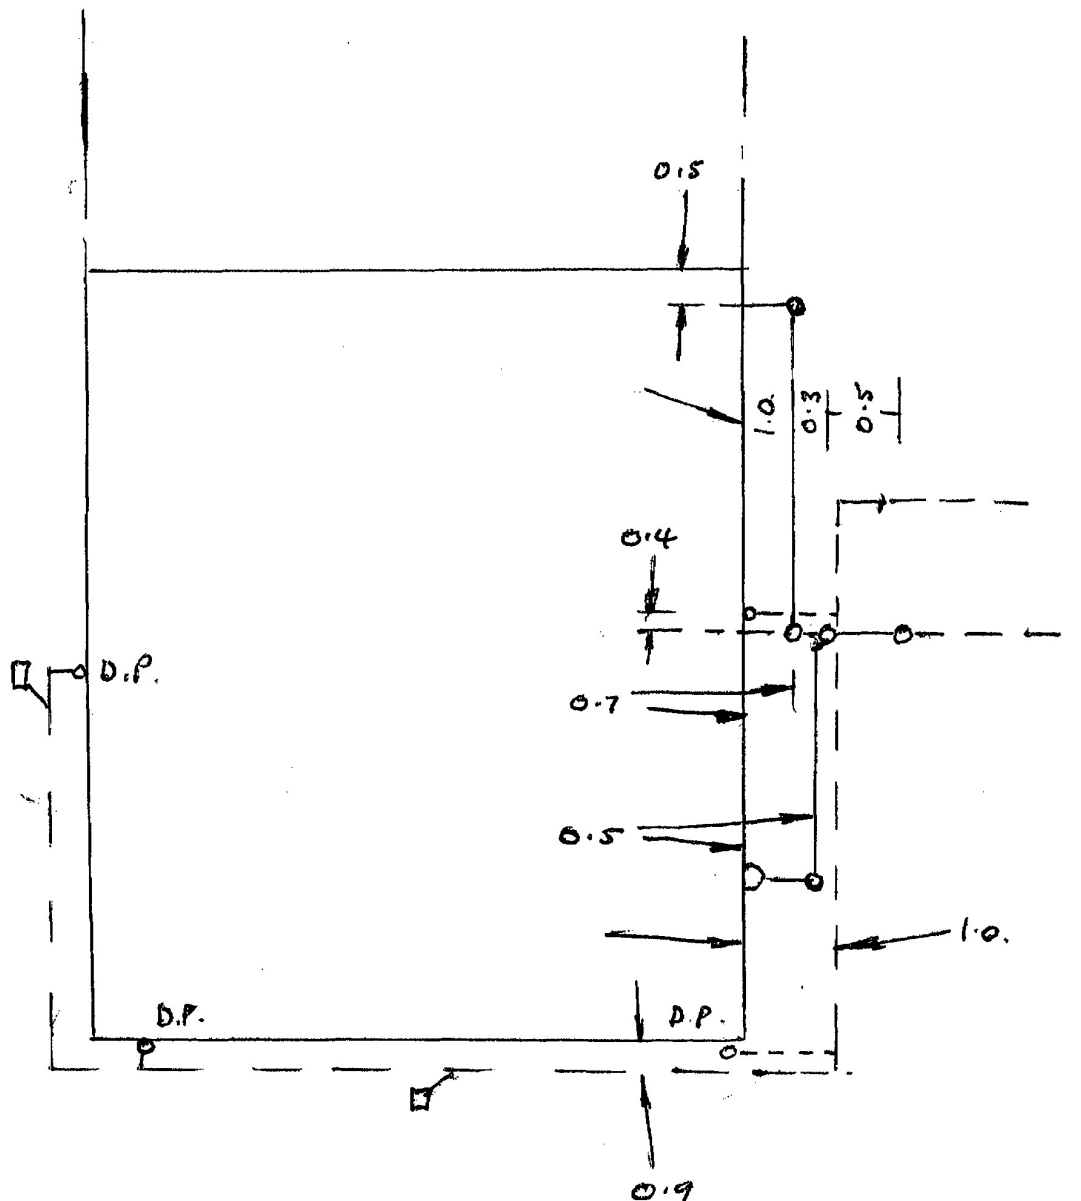

DRAINLAYER'S SIGNATURE:

GC Dwyer

DATE:

10.10.2000

STREET: _____ **No:** _____

LOT: 4 **DPS** _____

OWNER: _____

DRAINLAYER: Graham Dredge


INSPECTOR: _____

REG No: 12919

DATE OF INSPECTION: _____

CONSENT No: _____

DRAINLAYER PLEASE FILL IN ALL DETAILS

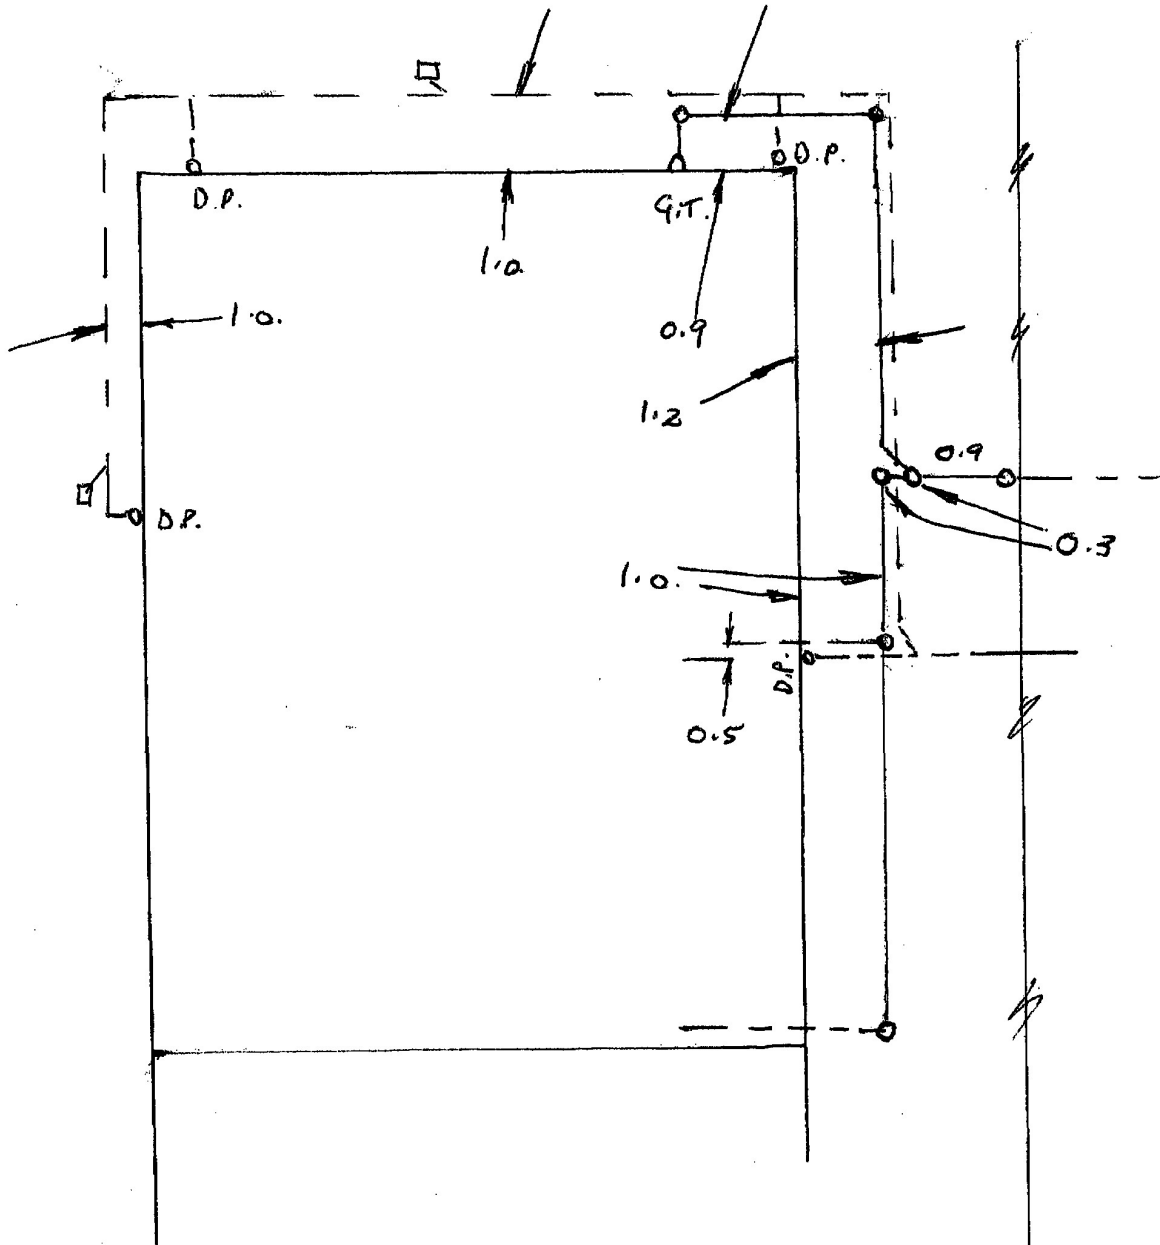

DRAINLAYER'S SIGNATURE: Graham Dredge

DATE: 12.10.2007