



Hamilton City Council

Te kaunihera o Kirikiriroa

Private Bag 3010, Hamilton, New Zealand.

FAX: (07) 838 6950

BUILDING UNIT

AS LAID DRAINAGE PLAN

STREET: CAMPBELL ST No: 60-6

LOT: _____ DPS _____

OWNER: CKL HOLDINGS LTD

DRAINLAYER: D.B. Robinson WPS

INSPECTOR: LANCE CUFF


REG No: 14754

DATE OF INSPECTION: 11/4/07

CONSENT No: _____

DRAINLAYER PLEASE FILL IN ALL DETAILS

STORMWATER
DRAINAGE

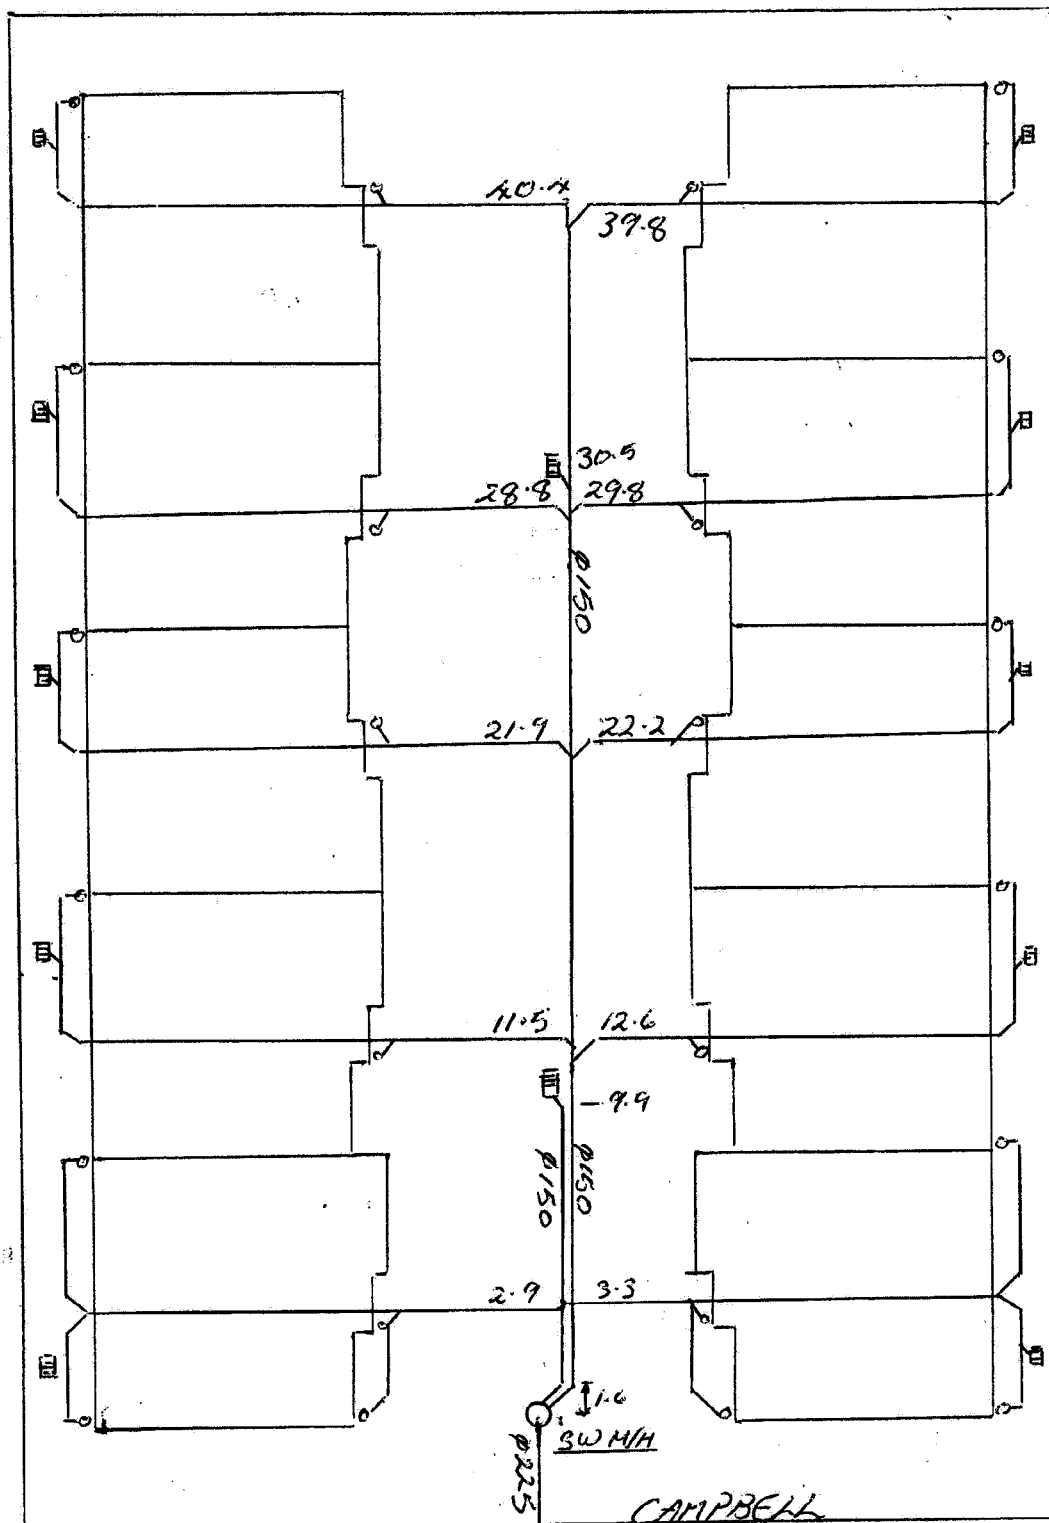

DRAINLAYER'S SIGNATURE: _____

DATE: 14/4/07