



WILLUGHBY/ABBOTSFORD DPS 12023 LOT PT. 1
BP 056994

RECEIVED
1 2 SEP 1986
BLDG. DIV.

RECEIVED
12 SEP
BLDG. DEPT.

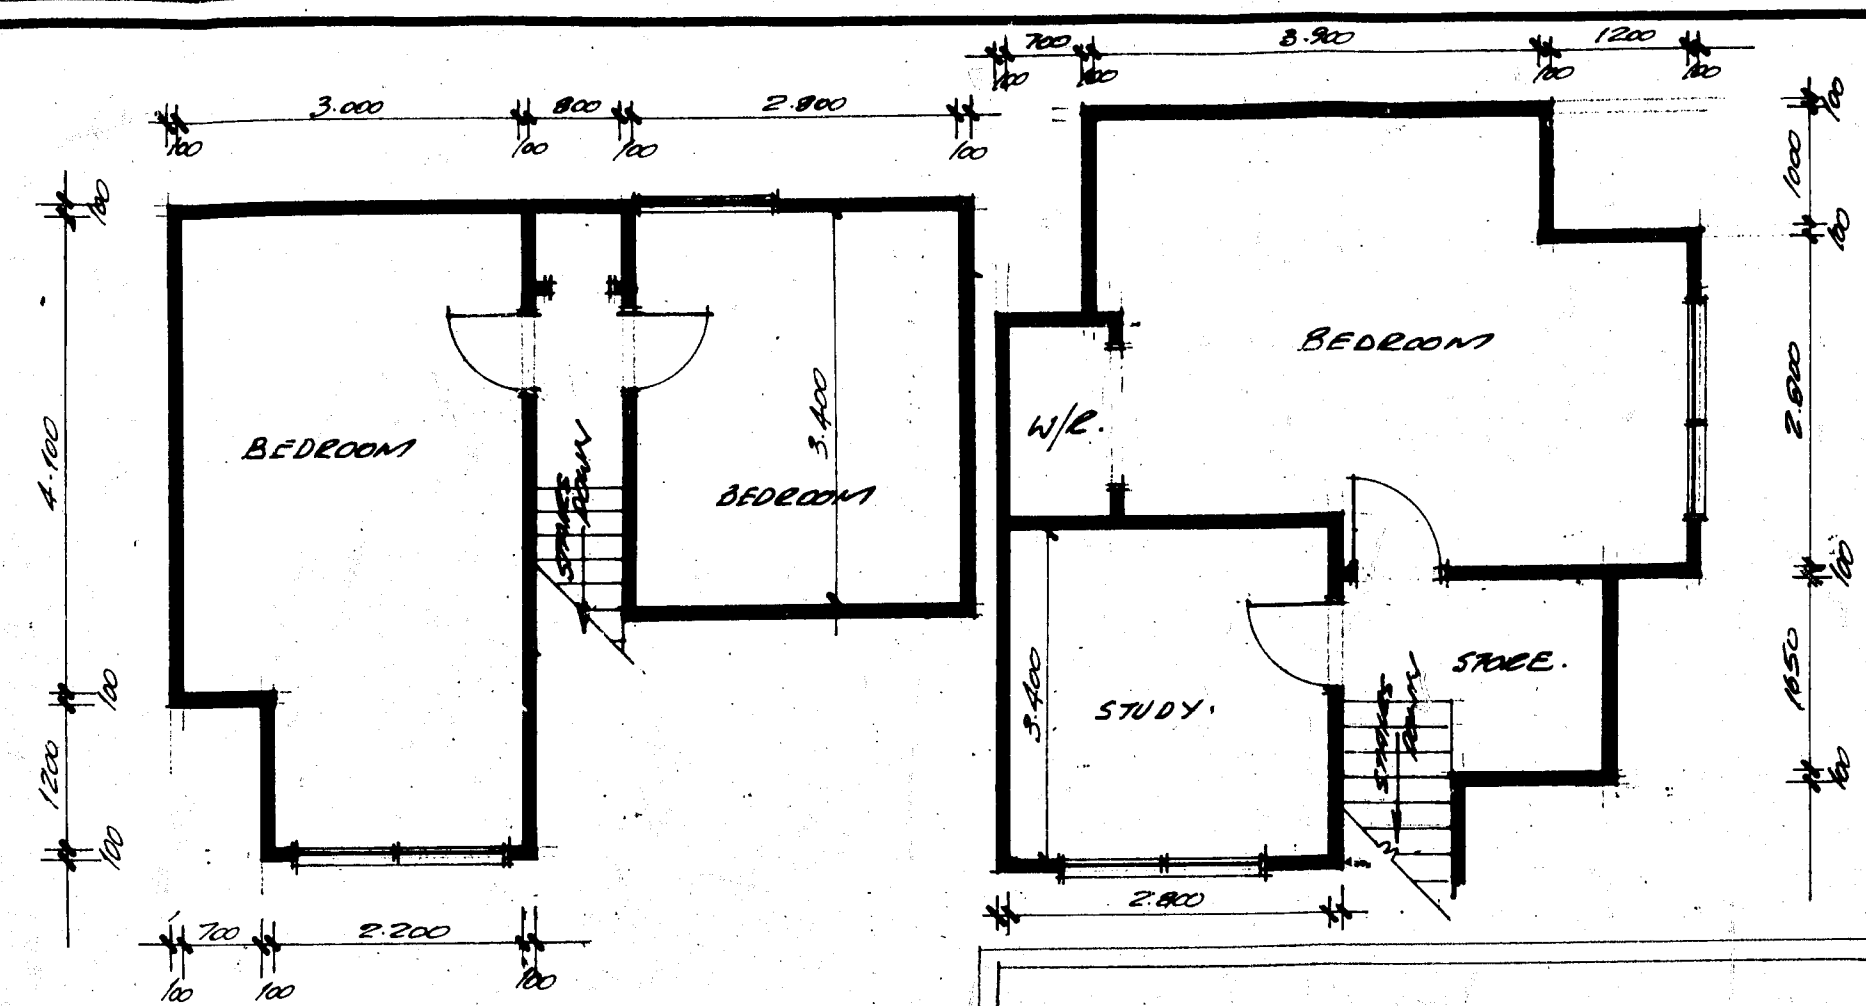


'LOFT' ROOM LAYOUT

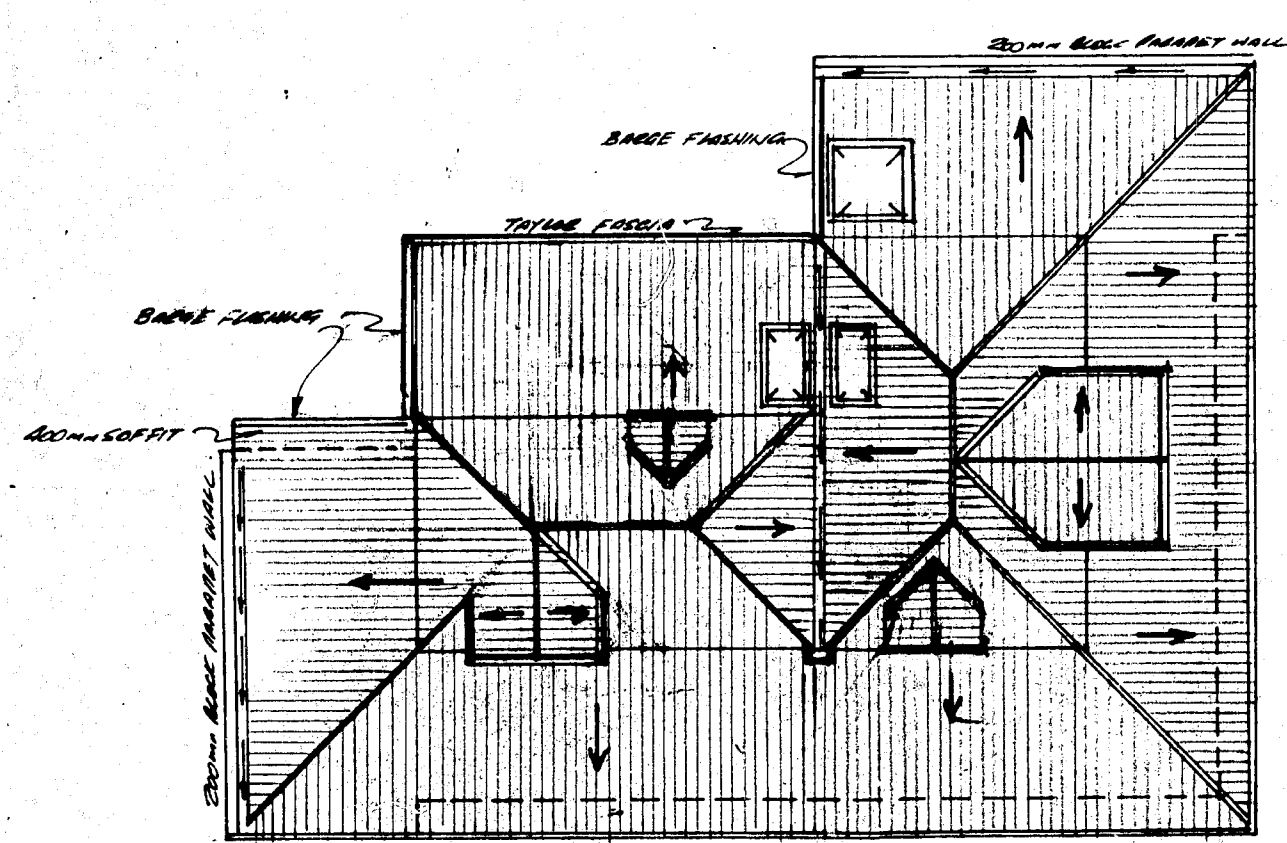

ROOF PLAN

SCALE: 1/100

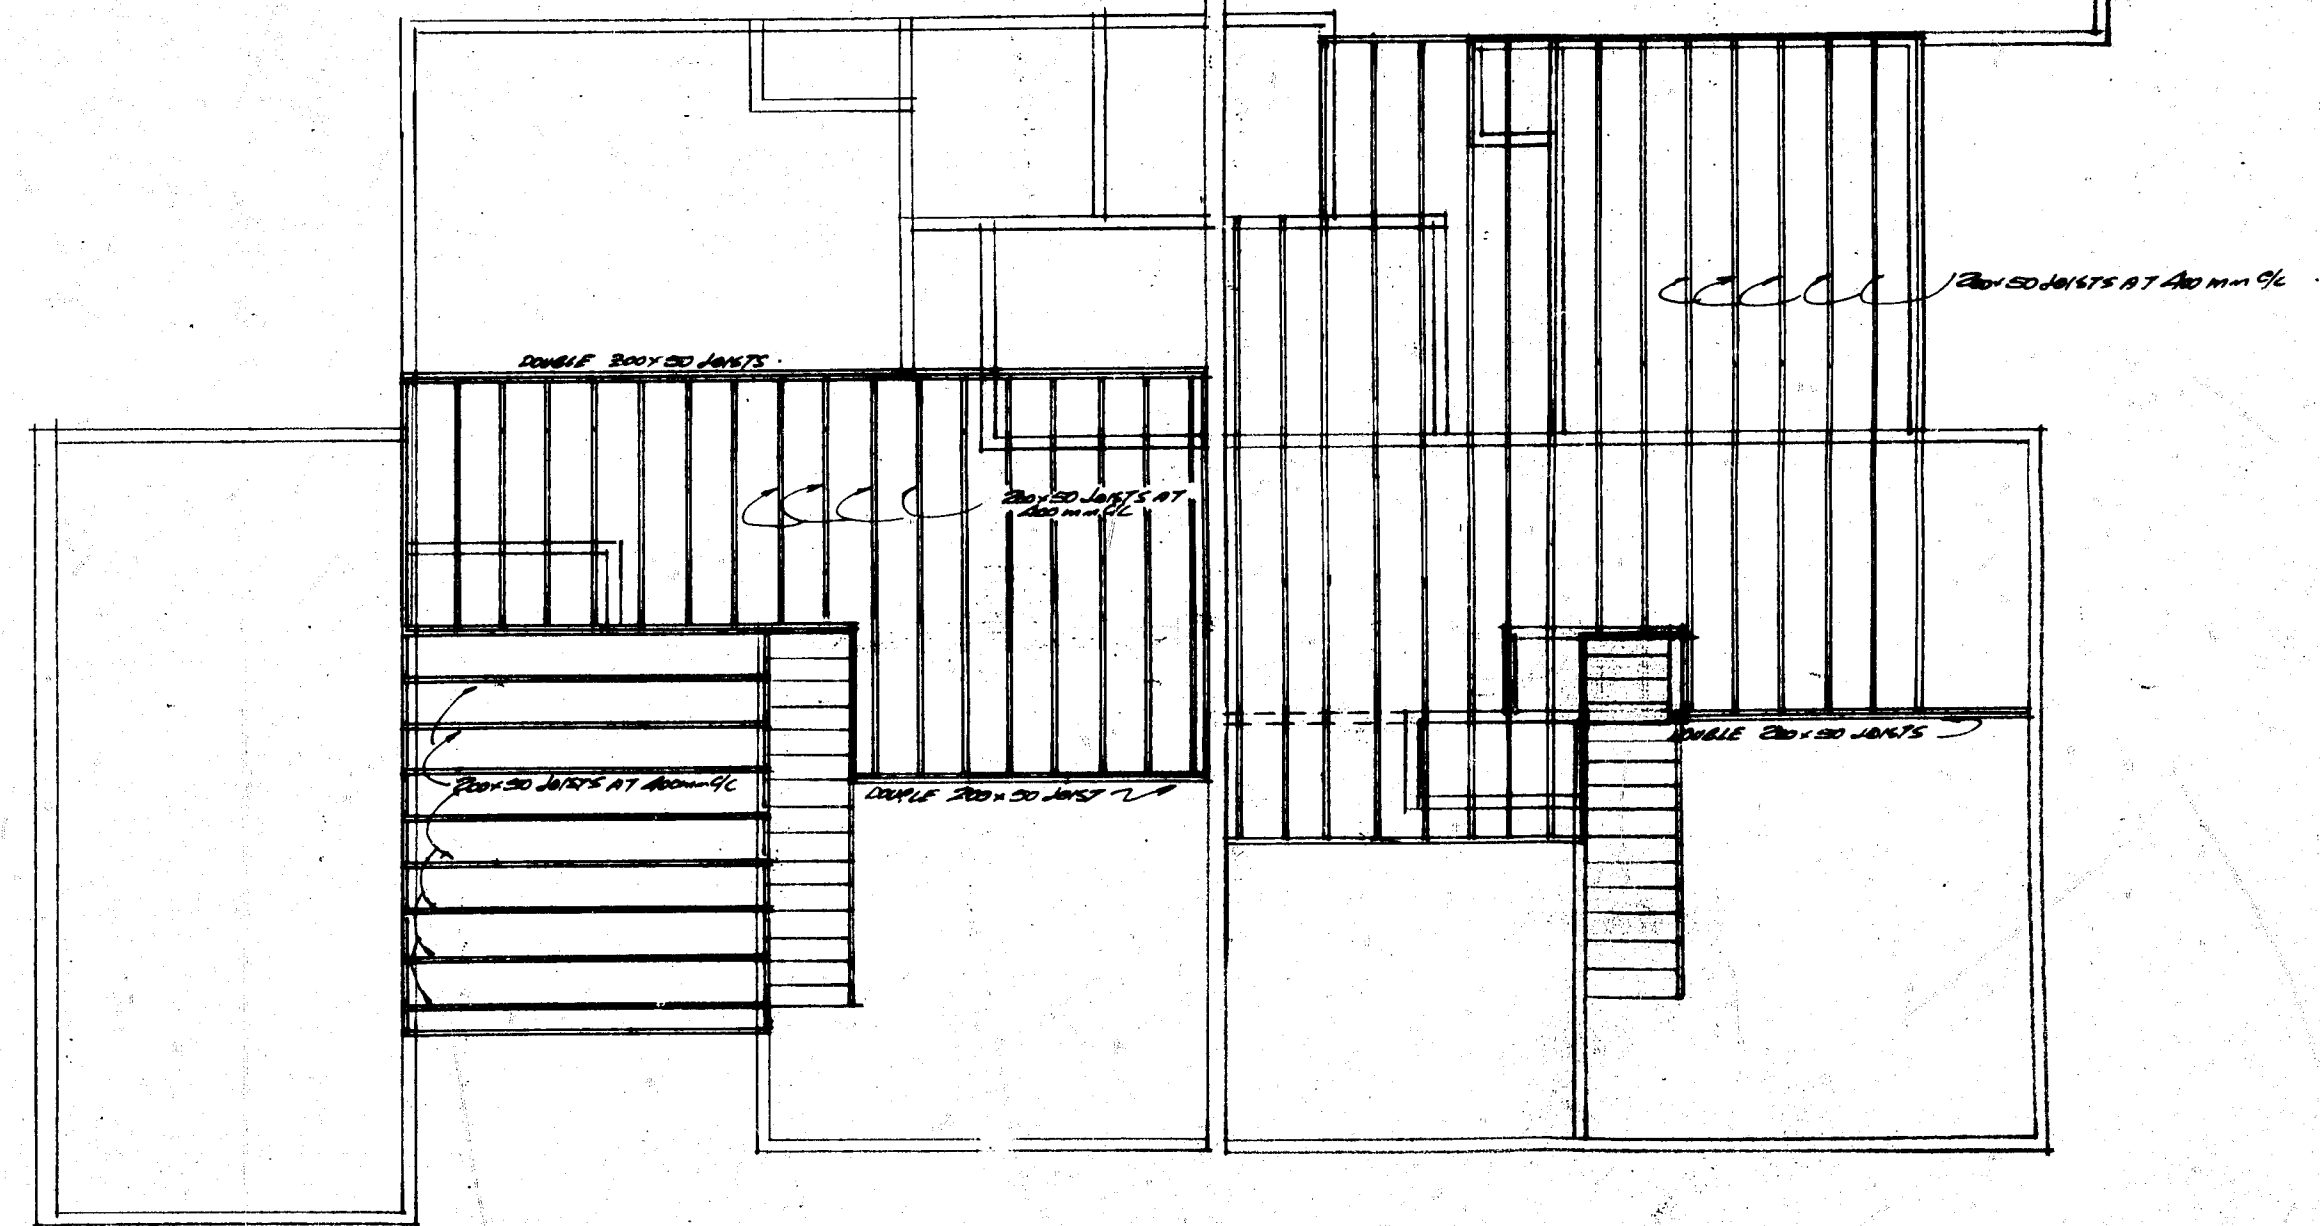

'LOFT' FLOOR JOIST LAYOUT



SCALE: 1/50

AMENDED 10.9.06 TO AS BUILT

Street CAR WILLOUGHBY
St. No. 2 ABBOTSFORD
D.P.S.: 12023
Lot: PT 1
B.P. No.: 056994
P. & DP. No.:
H.C.C. BUILDING RECORDS INDEX

PROPOSED 'DOUBLE HOME-UNITS' FOR
R.W.G. STACK & T.C.B. GRAY

DRAWN	CHECKED <i>B.H.</i>	SCALE 1/100	SHEET
TRACED	DATE 10.9.06	SCALE 1/50	SERIES OF

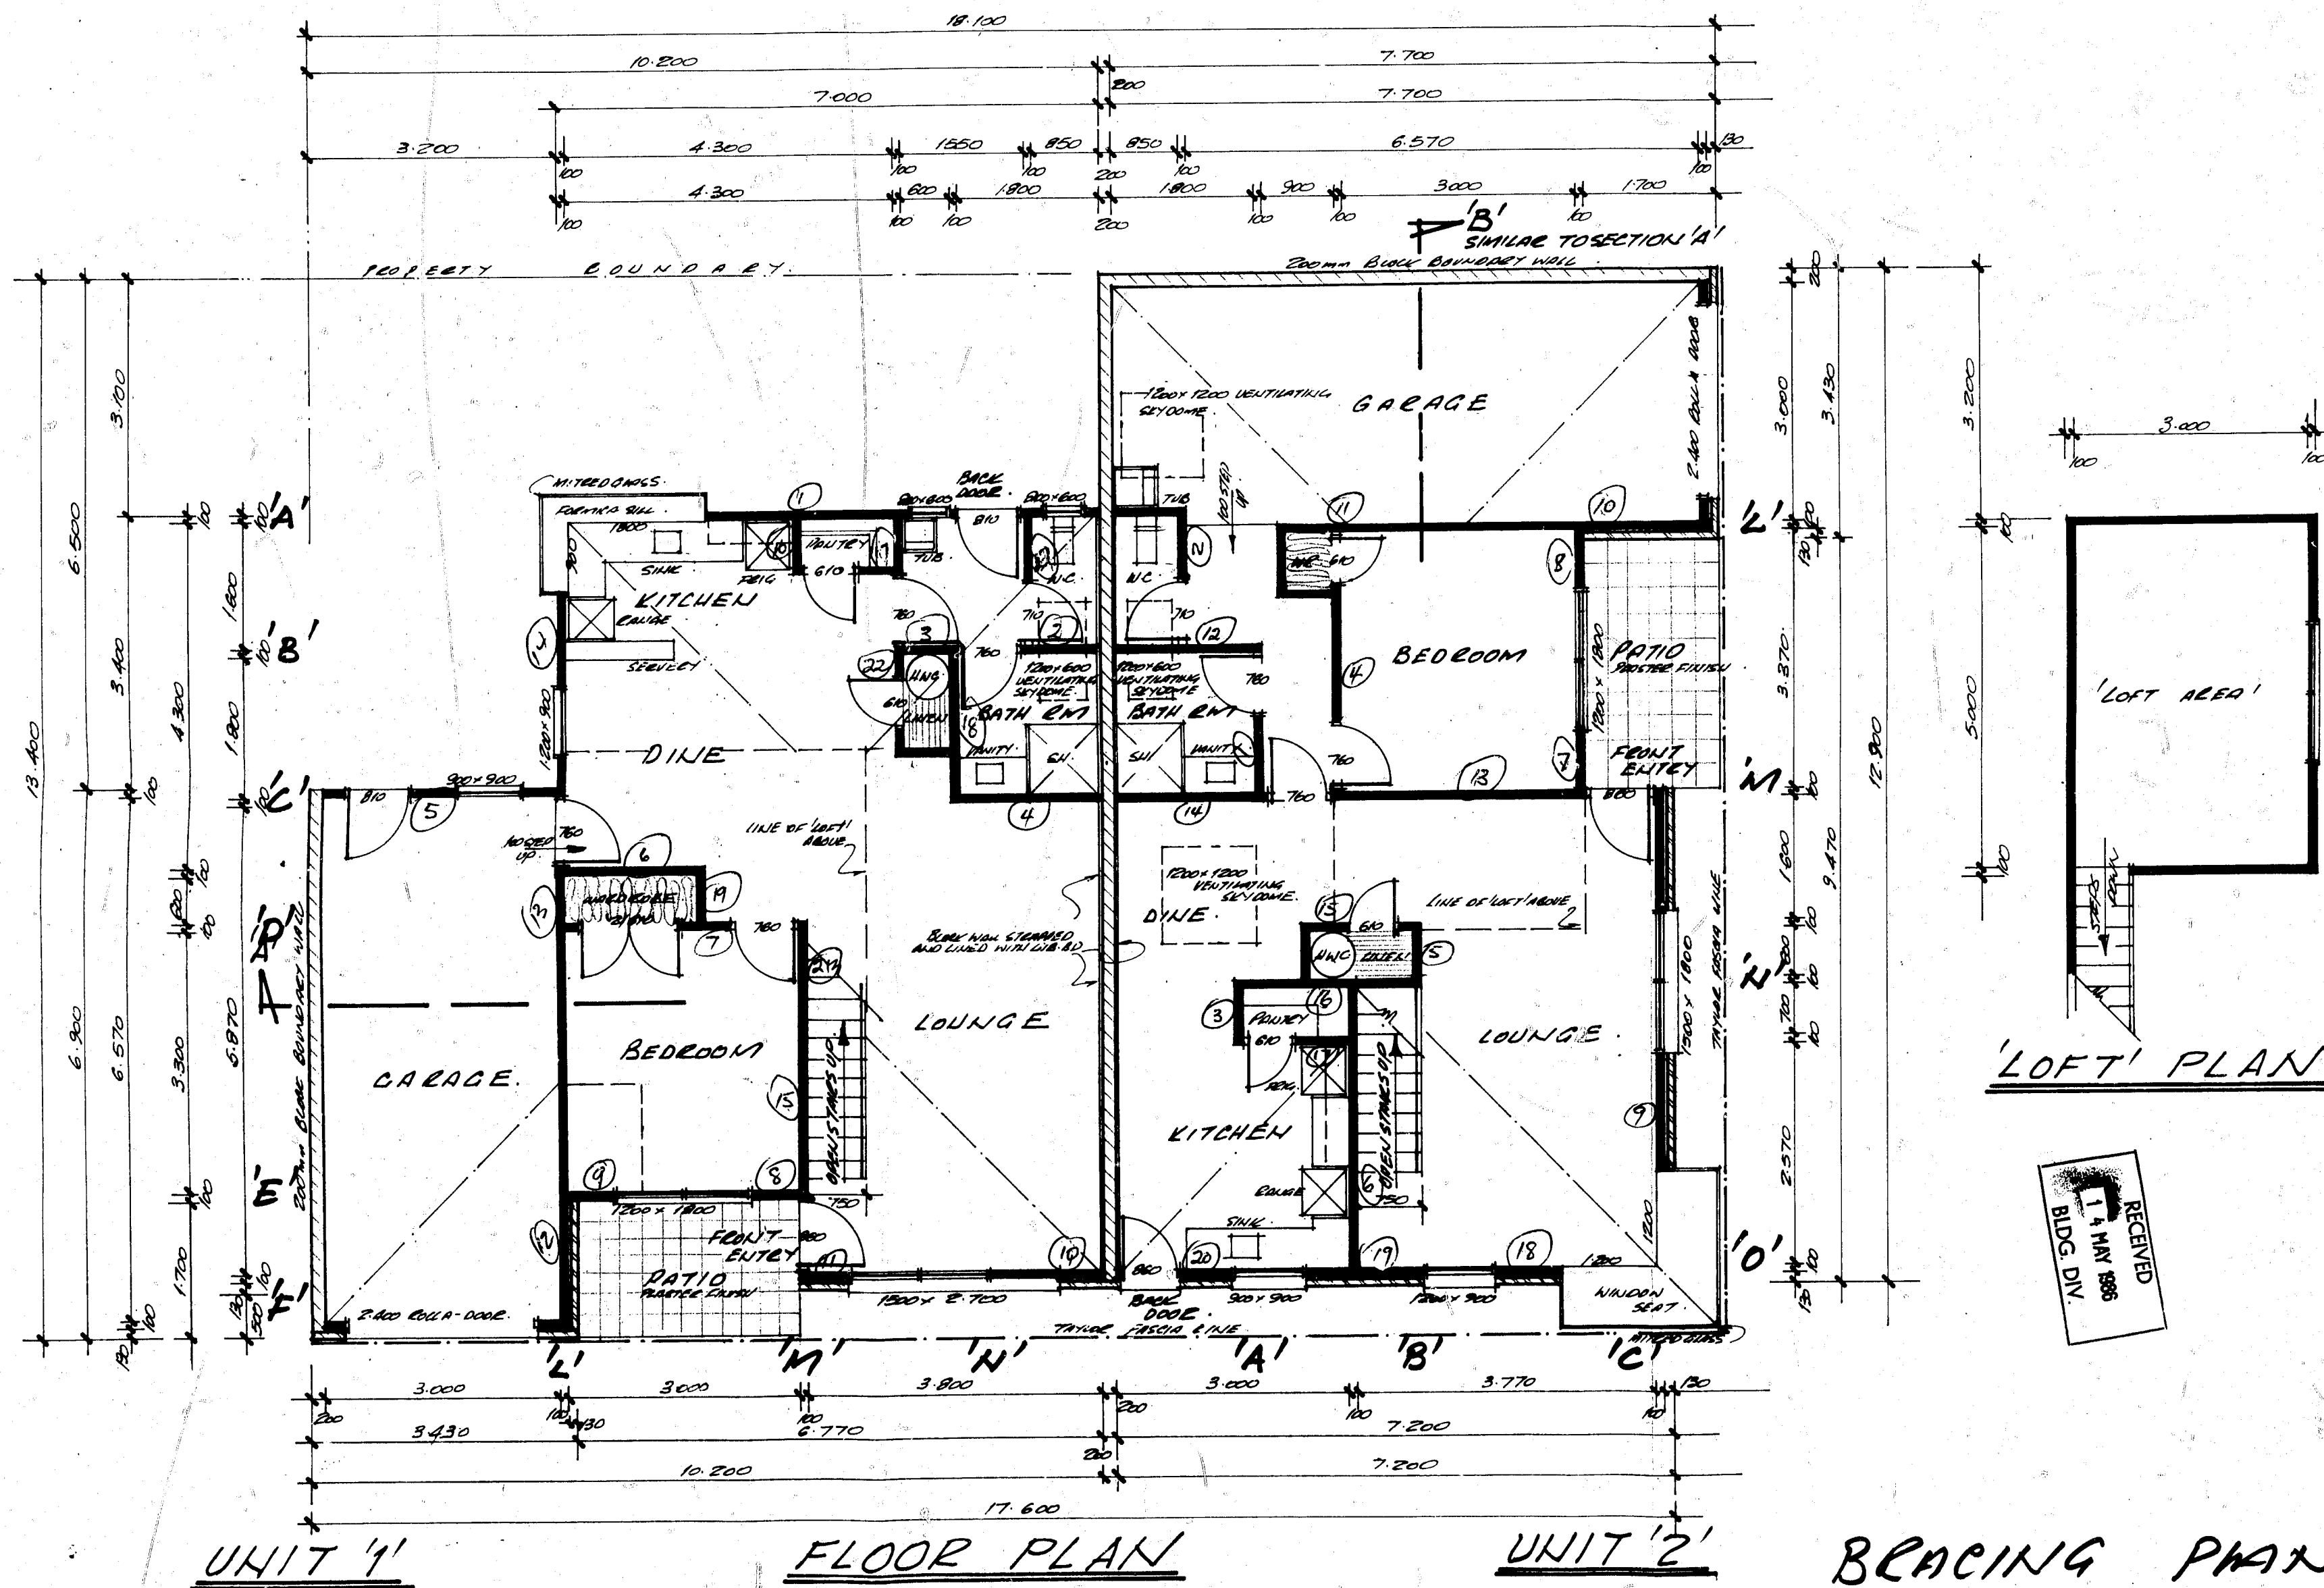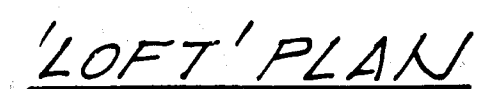

UNIT '1'

FLOOR PLAN

UNIT '2'

BLEACHING PLAN

Street CNR WILLOUGHBY
St. No. & ABBOTSFORD
D.P.S.: 12023
Lot: PT 1
B.P. No.: 056994
P. & DP. No.:
H.C.C. BUILDING RECORDS INDEX

DESIGNED BY:
BARRY P. MORRAN
3. BAILEY AVE
HAMILTON
PH. 52321 A/H.

BUILDER:
N.J. WEAL
6 BROOKVIEW CC.
HAMILTON
PU. 59435

PROPOSED 'DOUBLE HOME - UNITS' ————— FOR —————
R. W. G. STACK & T. C. B. GRAY —————
CNR. WILLOUGHBY STREET & ABBOTSFORD STREET — HAMILTON


FLOOR PLANS
SITE PLAN

DRAWN <i>E/L</i>	CHECKED <i>E/L</i>
TRACED	DATE <i>24: 4: 86</i>


SCALES 1: 50
1: 200

SHEET

SERIES OF REF
--

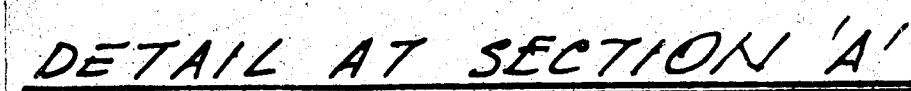

SCALE. 1:100

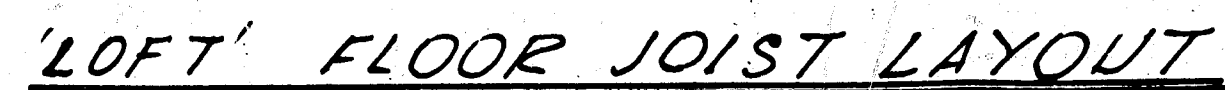

SCALE: 1:50

AMMENDED 10:9:86 TO AS BUILT'

Street CNR WILLOUGHBY
St. No. & ABBOTSFORD
D.P.S.: 12023
Lot: PT 1
B.P. No.: 056994
P. & DP. No.:
H.C.C. BUILDING RECORDS INDEX

P. & DP. No.: P&DP RECORDS SECTION
H.C.C. BUILDING RECORDS INDEX



Age	Percentage correct
10	100
11	100
12	100
13	100
14	100
15	100
16	100
17	100
18	100

THE A. J. RAY COMPANY

SWEET

PROPOSED 'DOUBLE HOME-UNITS' ————— FOR
R.W.G. STACK & T.C.B. GRAY —————

DRAWN	CHECKED <i>[Signature]</i>	SCALES 1:100 1:50	SERIES OF
TRACED	DATE 10-9-86		REF

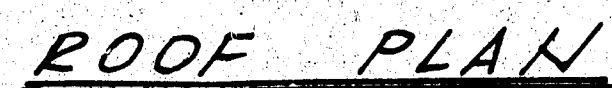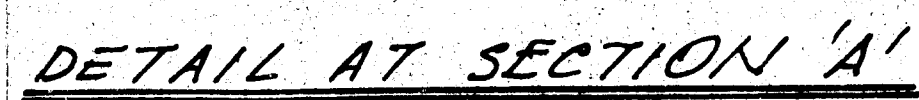

SALE. 1.100



SCALE: 1:50

AMMENDED 10:9:86 TO AS BUILT

Street CNR Willoughby
St. No. 2 ABBOTSFORD
D.P.S.: 12023
Lot: PT 1
B.P. No.: 056994
P. & DP. No.: _____
H.C.C. BUILDING RECORDS INDEX

PROPOSED 'DOUBLE HOME-UNITS'
R.W.G. STACK & T.C.B. GRAY

FOR


DRAWN	CHECKED <i>ELH</i>	SCALES 1:100	SERIES OF
TRACED	DATE 10.9.06	1:50	REF

SHEET **1**

SERIES OF **3**

REF


WILL LOUGHBY / ABBOTSFORD DPS 12023 LOT PT. 1
BP 056994

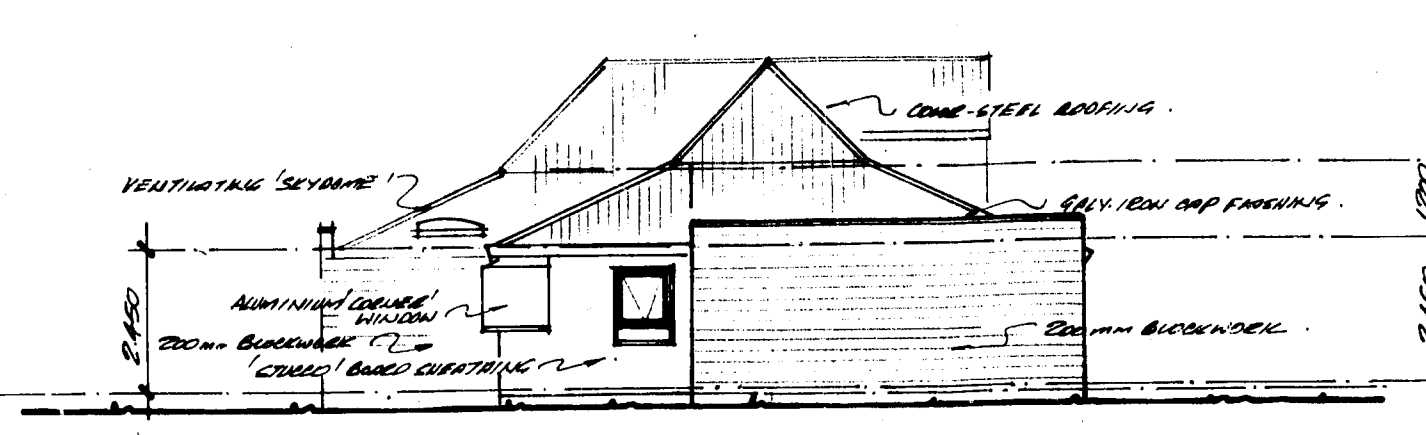


NORTHERN SIDE ELEVATION




WEST (WILLOUGHBY ST) ELEVATION

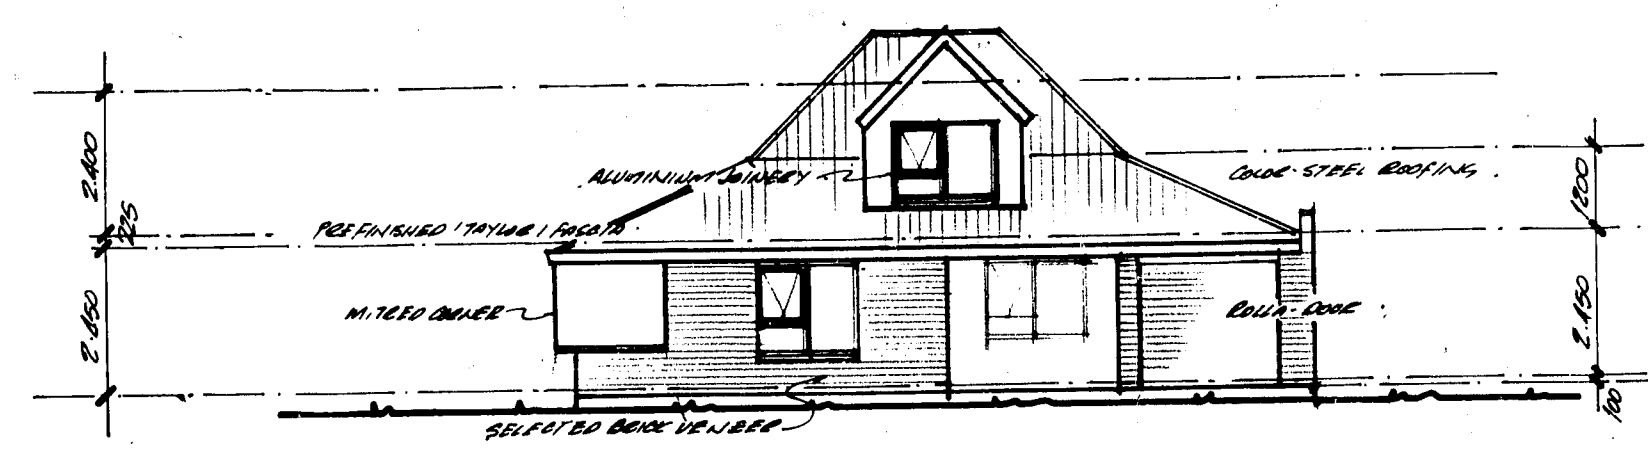

SOUTH (ABBOTSFORD ST) ELEVATION

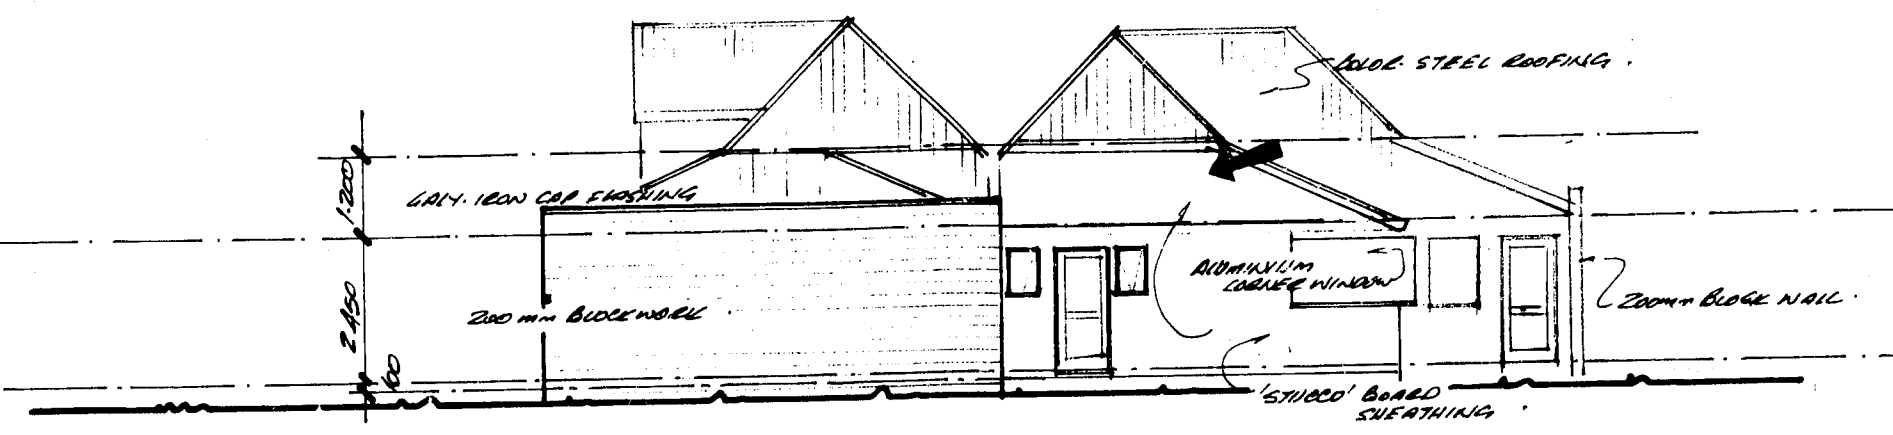


EASTERN SIDE ELEVATION

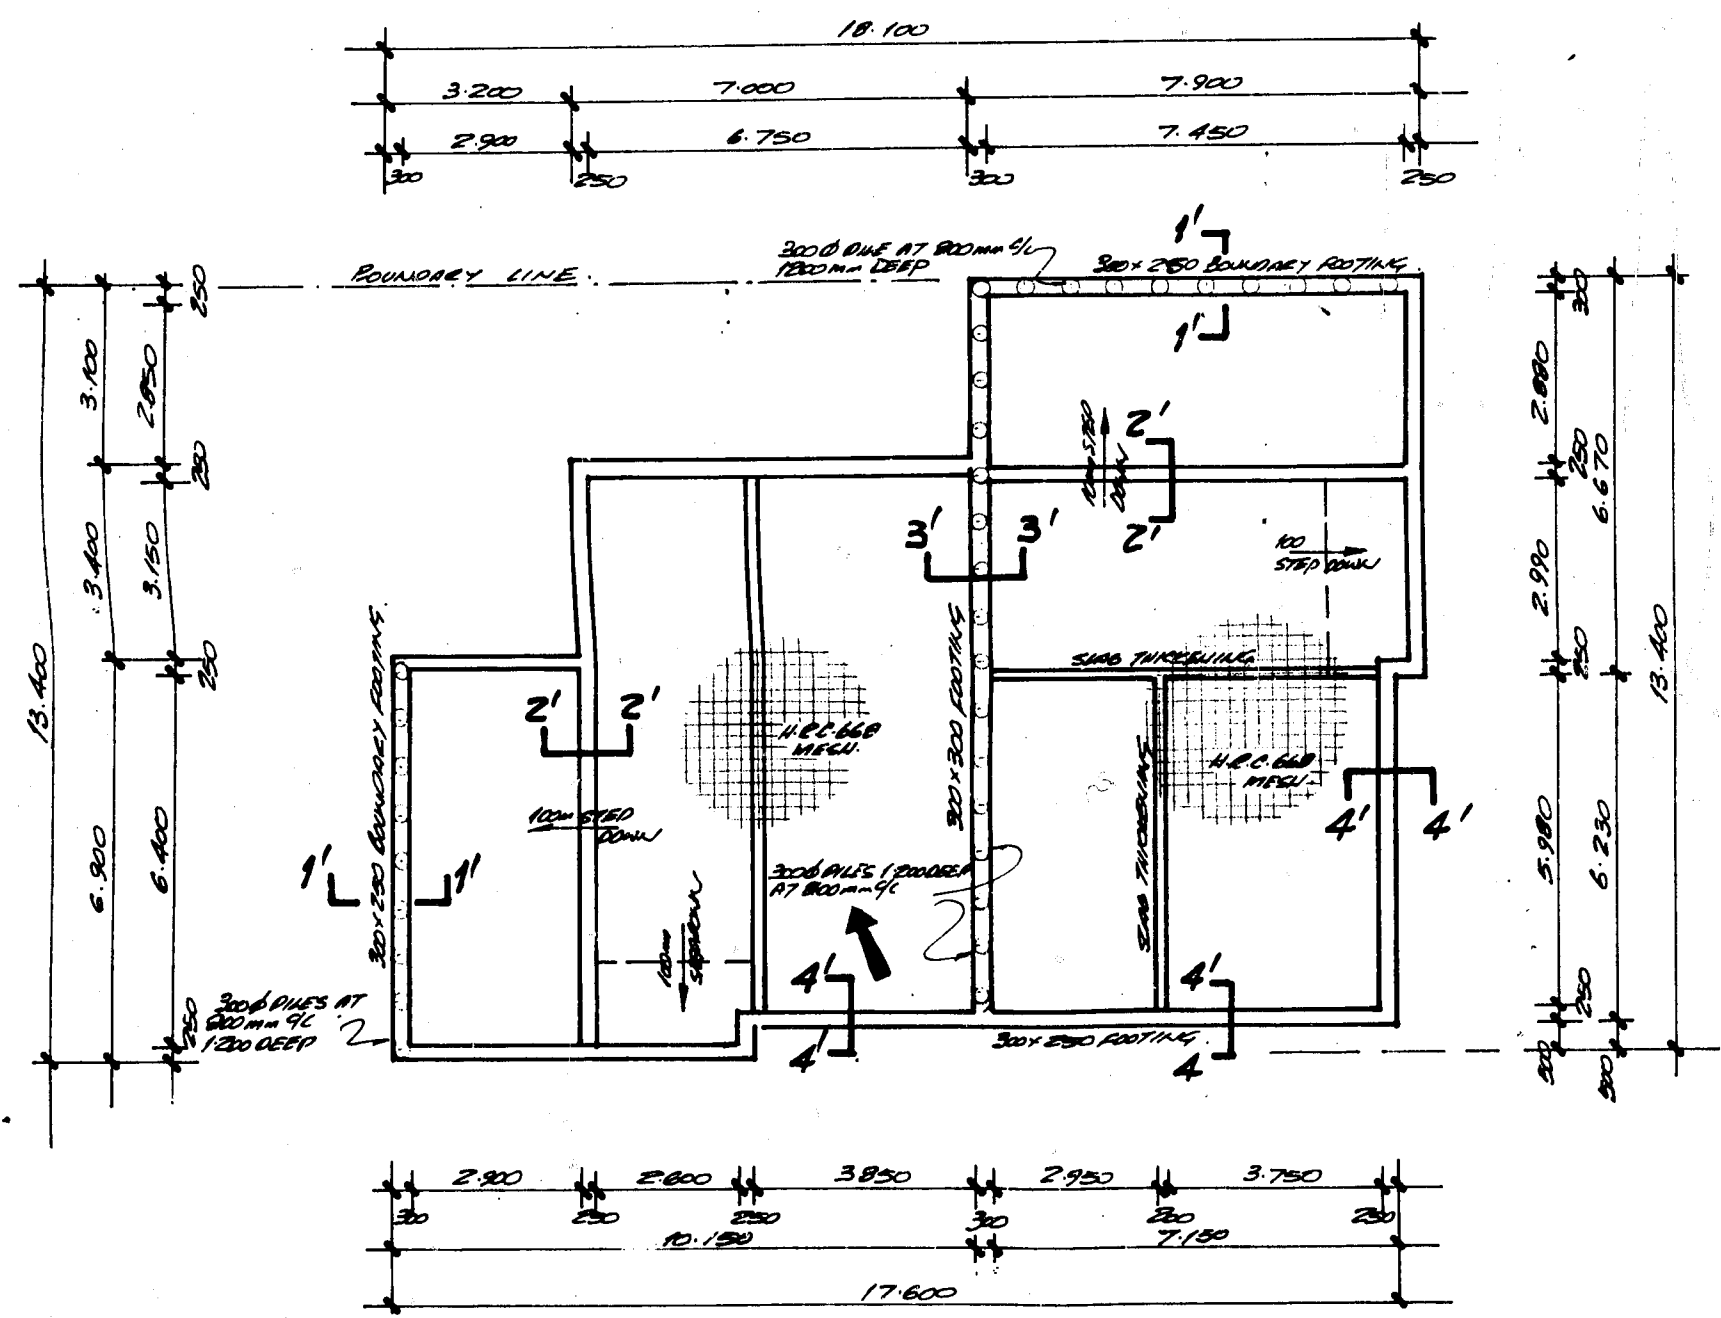


FOUNDATION PLAN


TO BE READ IN CONJUNCTION WITH FLOOR PLAN

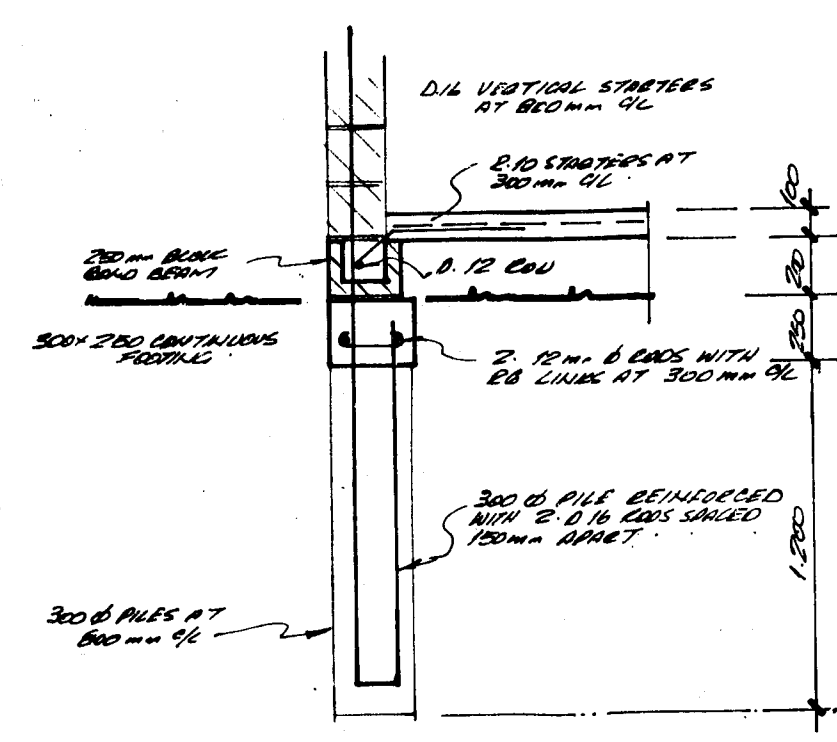

DETAIL '1-1'

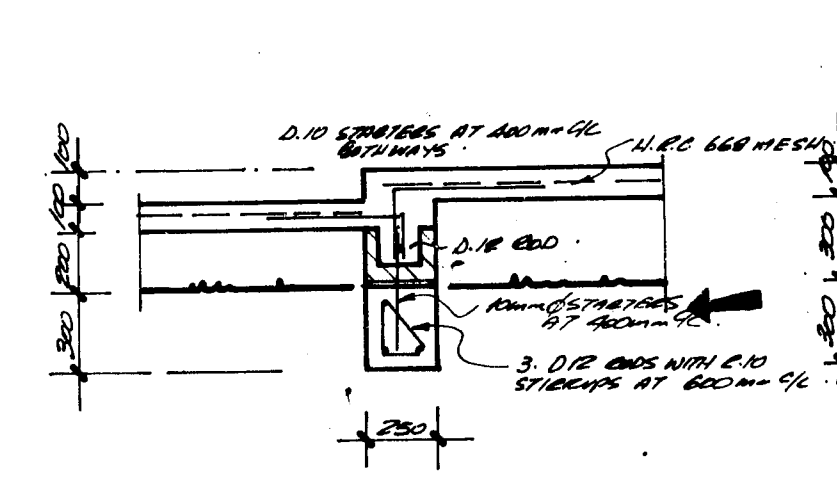

DETAIL '2-2'

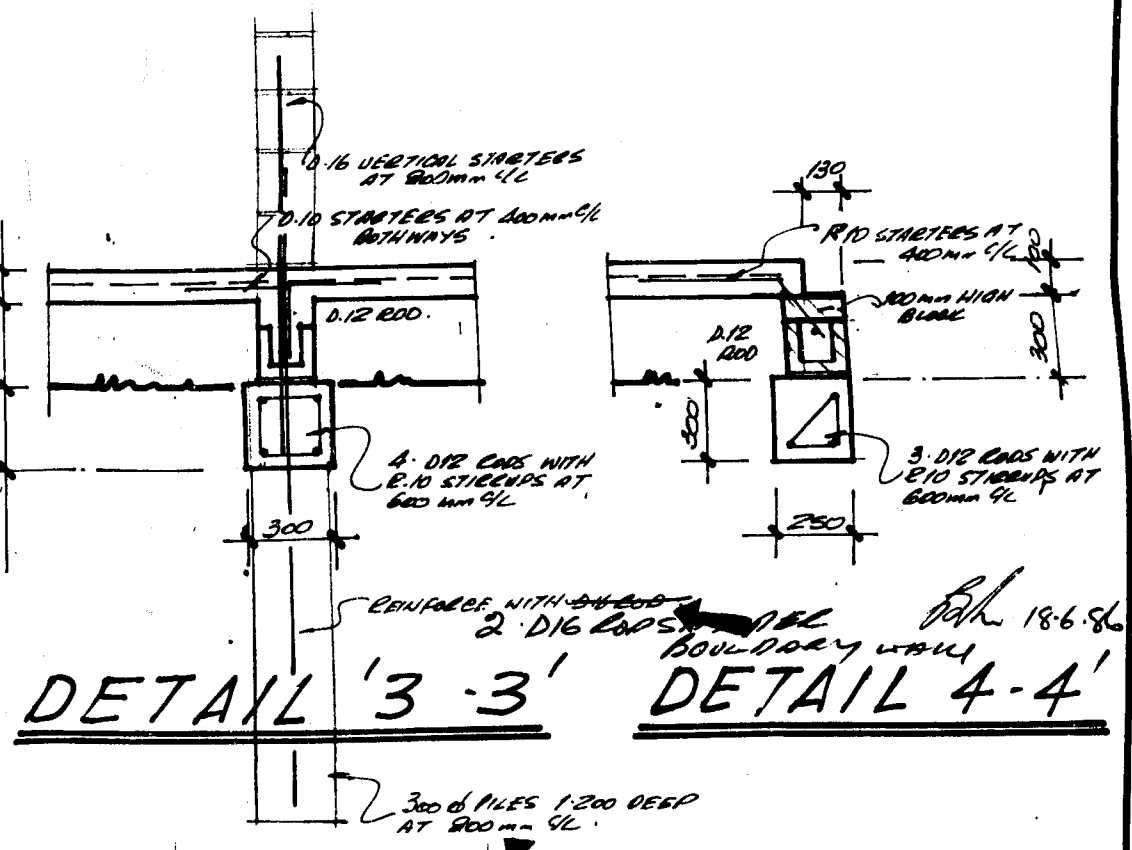

DETAIL '3-3'


DETAIL '4-4'

Street CNR. WILLOUGHBY
St. No. 2 ABBOTSFORD
D.P.S.: 12023
Lot: PT
B.P. No.: 056994
P. & DP. No.:
H.C.C. BUILDING RECORDS INDEX

RECEIVED
11 JUN 1988
BLDG. DIV.


PROPOSED 'DOUBLE HOME-UNITS' — FOR —
R.W.G. STACK & T.C.B. GRAY
CNR. WILLOUGHBY STREET & ABBOTSFORD STREET — HAMILTON

ELEVATIONS FOUNDATION DETAILS			SHEET 2
DRAWN <u>BL</u>	CHECKED <u>AT</u>	SCALES <u>1:100</u> <u>1:20</u>	SERIES OF <u>3</u>
TRACED	DATE <u>24.4.88</u>	REF	

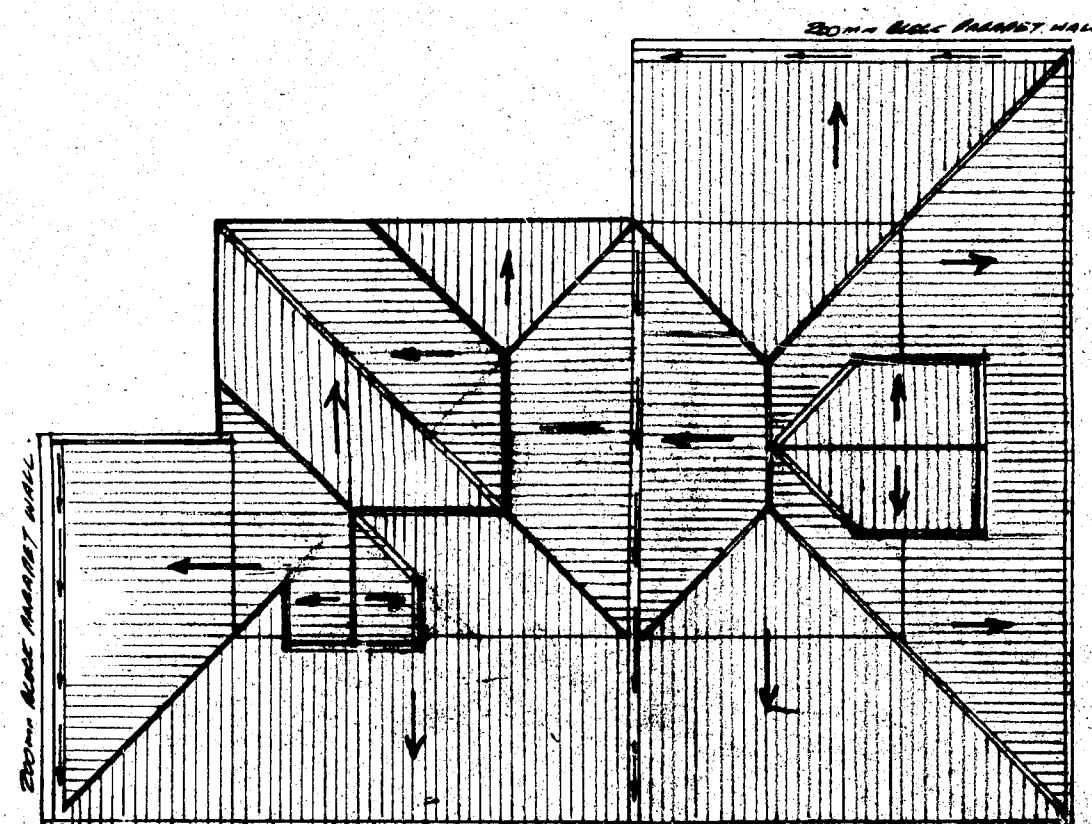

ROOF PLAN

SCALE: 1/100

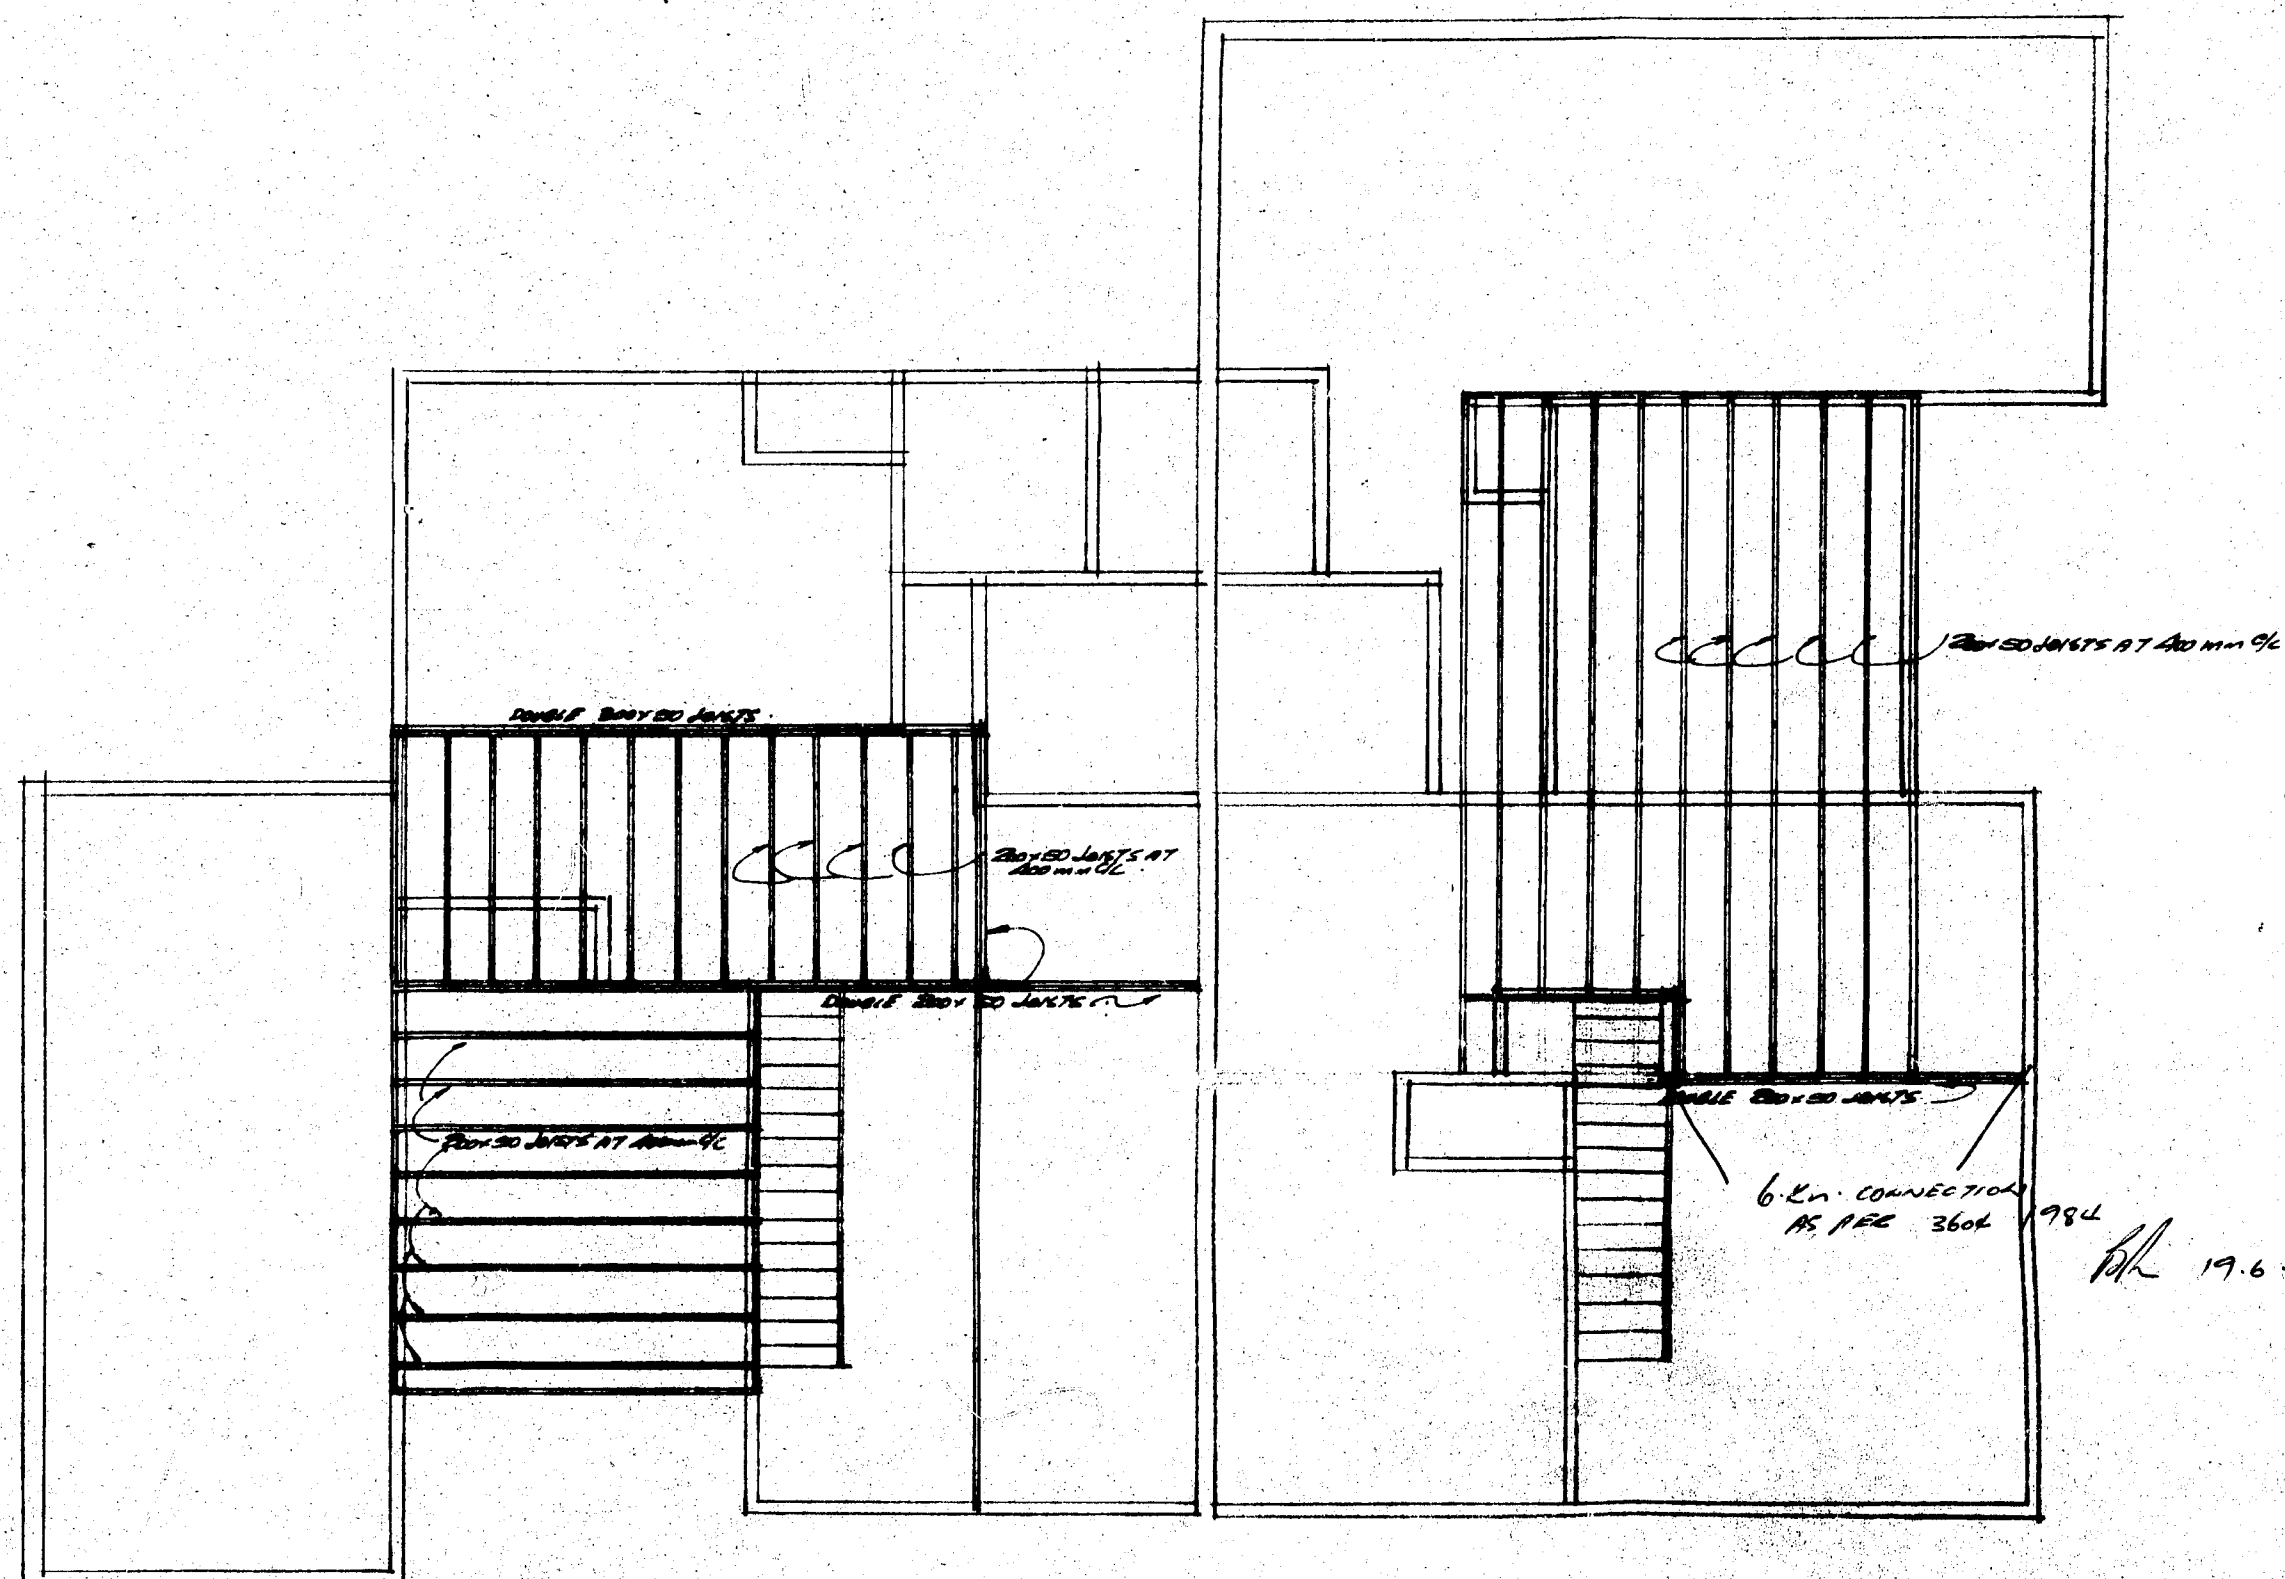

'LOFT' FLOOR JOIST LAYOUT

SCALE: 1/50

Street CNR WILLOUGHBY
St No. 2 ABBOTSFORD
D.P.S.: 12023
Lot: PT 1
B.P. No.: 056994
P. & DP. No.:
H.C.C. BUILDING RECORDS INDEX


RECEIVED
11 JUN 1986
BLDG. DIV.

PROPOSED 'DOUBLE HOME-UNITS' FOR
R.W.G. STACK & T.C.B. GRAY


DRAWN	CHECKED	SCALE	SHEET
TRACED	DATE		SERIES OF
			REF

RECEIVED
10 APR 1984
BLDG. DIV.

HAMILTON C.
APPL
SUBJECT TO
TO BE KE

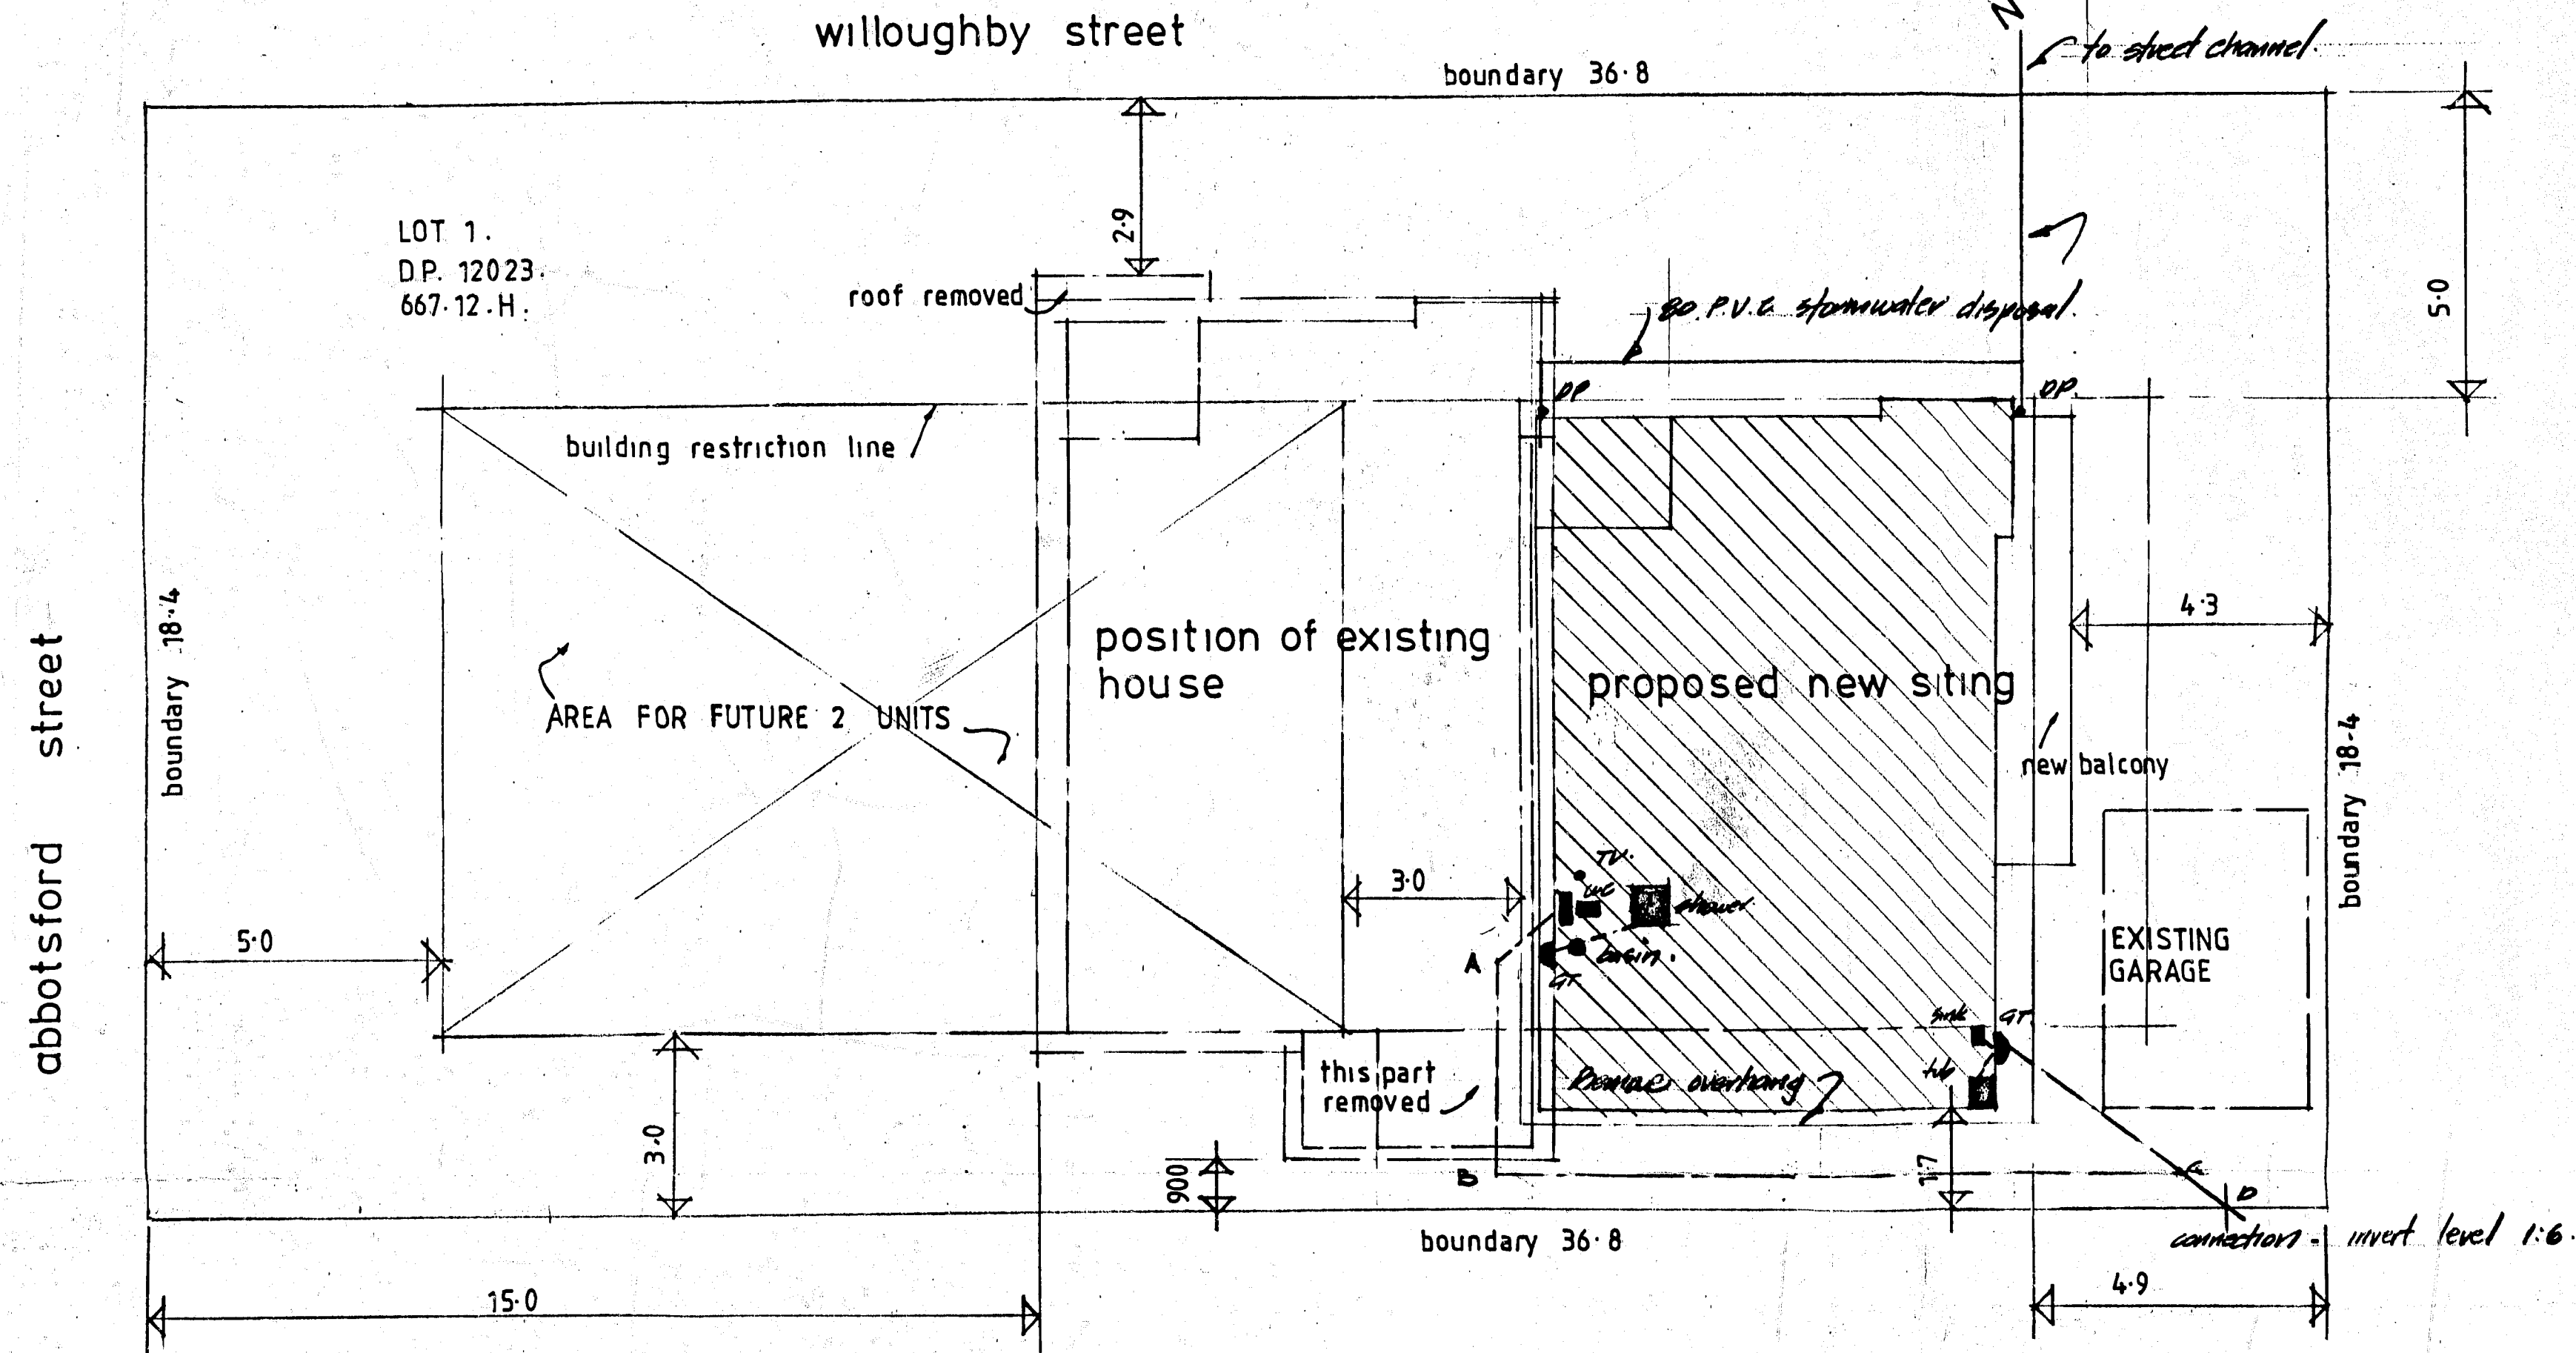

SITE PLAN 1:100

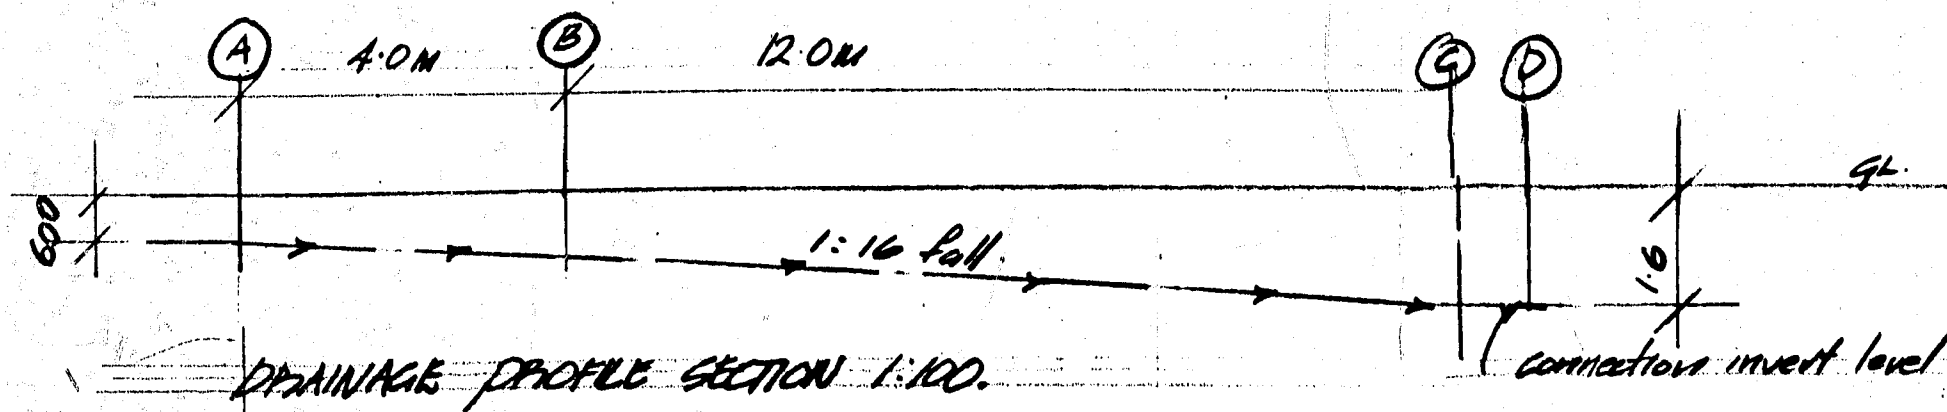

Street ONR WILLOUGHBY
St. No. 2 ABBOTSFORD
D.P.S.: 12023
Lot: PT 1
B.P. No.: 056994
P. & DP. No.:
H.C.C. BUILDING RECORDS INDEX

PLAN PROPOSED RESITING OF HOUSE AT 40 WILLOUGHBY STREET.
HAMILTON. FOR MR. R.W.G. STACK.

DRAWN	CHECKED	SCALES	SHEET
TRACED	DATE		SERIES OF
			REF