




015360
CITY OF HAMILTON

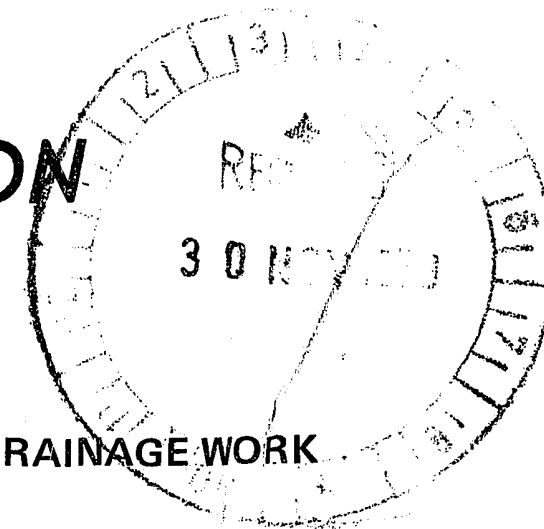

APPLICATION FOR PERMIT FOR SANITARY, PLUMBING AND DRAINAGE WORK

I, the undersigned (name in full) BOB MUIR LTD.
of (address) 33 DUNS DALE RD

hereby make application for permission to carry out the work prescribed herein, as set out in the plans attached hereto, at the premises situated in:—

11 BLONFIELD Street/Road, being Lot 62

D.P.S. 24251

Name and address of owner of premises: SPACELINE LTD

HAMILTON

Nature of work Sewer & S/W

Value of proposed work including materials \$ 500

(a) Plumbing

(b) Drainage (including stormwater)

Regd. No. 05150 Licensed Plumber

Regd. No. R M Muir Licensed Drainlayer

Dated this 26 day of Nov 19779

B/P 56836

1400
85
16

MICROBOX

HAMILTON CITY COUNCIL

CITY ENGINEER'S DEPARTMENT

PLUMBING AND DRAINAGE DIVISION

DRAIN PLAN FOR:

Permit No.: 015630

Lot No.: 62 D.P.S. No.: 24251 Street: 11 BLONFIELD ST

Owner: SPACELINE Homes Address: BLONFIELD ST

Type of Building: W/B

Drainlayer: R. M. MUIR Address: 33 DUNS DALE RD

Date of Inspection: 7.12.79 EB

NOTE:— Drain plans to be drawn in ink on the reverse side of this form shall be as hereunder:—


- 1 Drawn to a scale of 1:100 unless otherwise agreed upon by the Inspector.
- 2 New sewage drains to be drawn in red ink; existing drains in full black, where position is known.
- 3 New stormwater drains are to be drawn in green ink; existing stormwater drains in dotted black, where position is known.

The plan shall also include:—

- (a) The details of the whole or part of the building, etc., to be drained.
- (b) The correct position of the whole or part of the building to be drained in relation to the nearest front and side, or rear and side, boundaries.
- (c) The correct position of the drain in relation to the building and the boundaries.
- (d) The gradient(s) of drain.
- (e) Where the street frontage lies.
- (f) The approximate north point of the site.

Inspector's Report:

Scale 1:100
1 meter
2m
6m

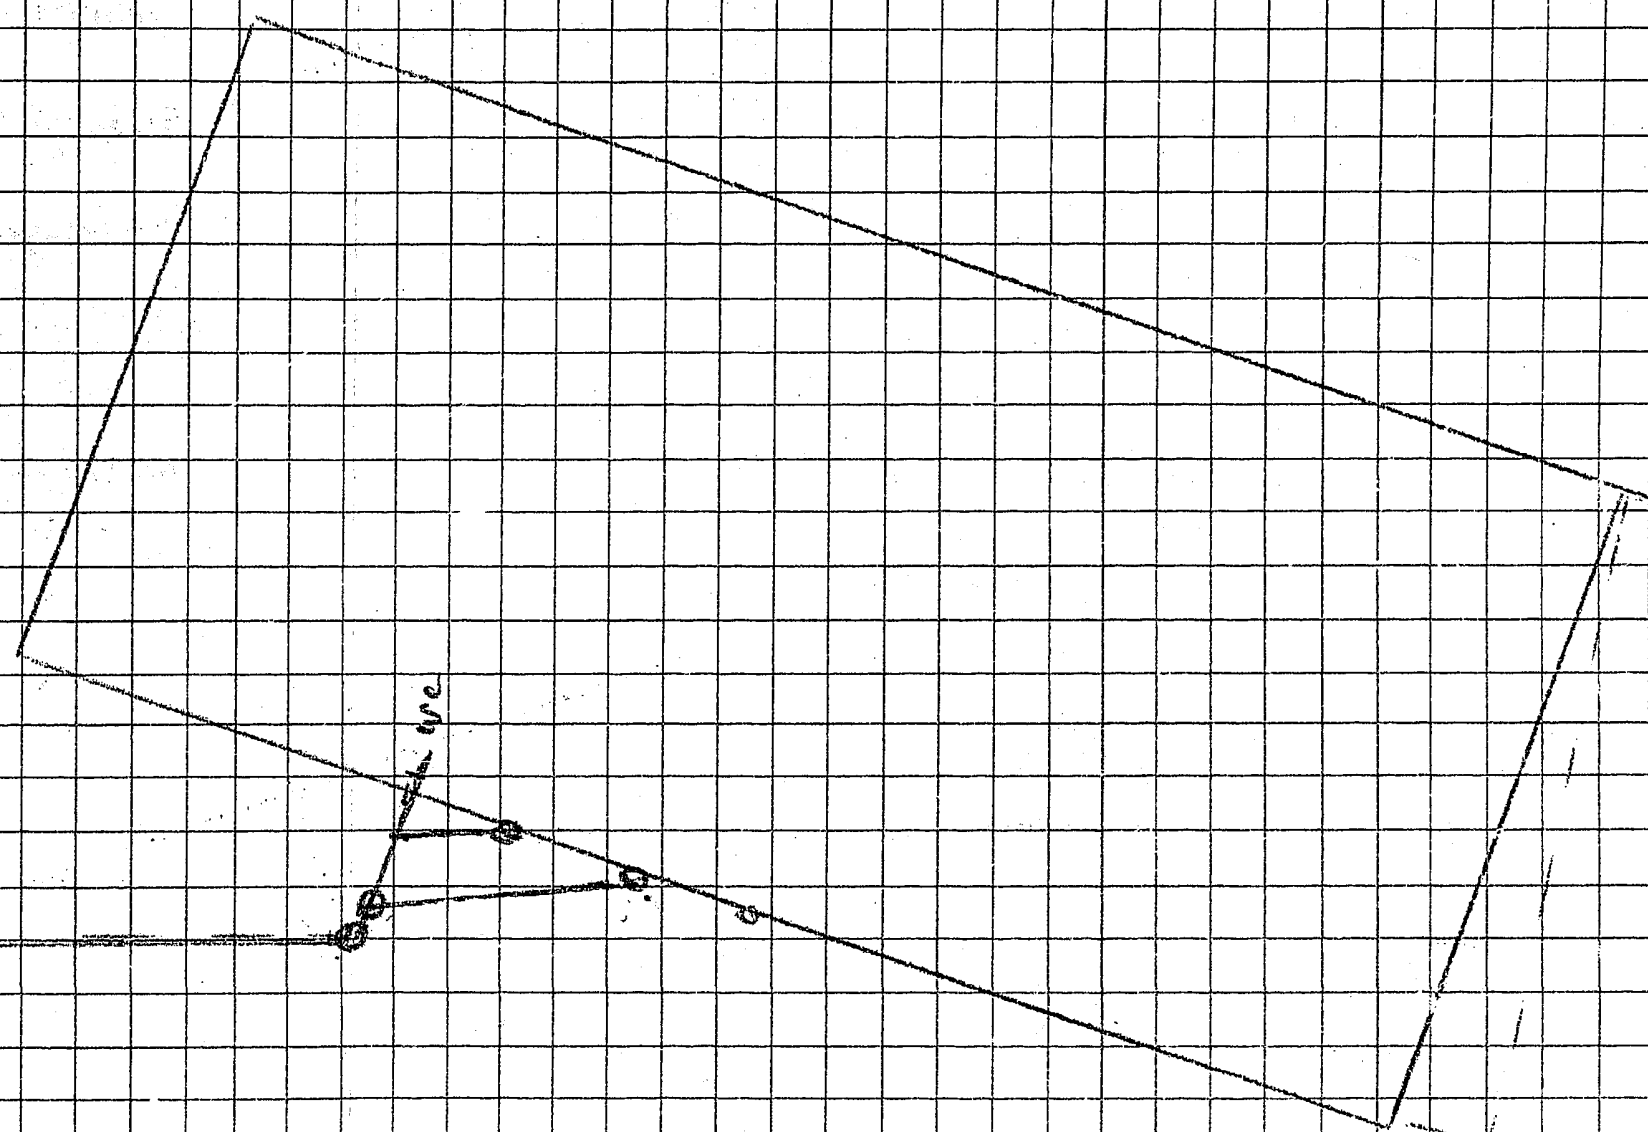

11 Bloomfield ST

MICROBOX

4

3