




AS LAID DRAINAGE PLAN

|  |                                   |
|--|-----------------------------------|
| STREET: <u>2 Barkwood</u> No: <u>245</u> | LOT: <u>95</u> DPS <u>3 10511</u> |
| OWNER: <u>Mohohan - Wilson</u>           | DRAINLAYER: <u>Peter Brown</u>    |
| INSPECTOR: _____                         | REG No: <u><del>03</del> 3557</u> |
| DATE OF INSPECTION: _____                | CONSENT No: <u>2004/9604</u>      |

**DRAINLAYER PLEASE FILL IN ALL DETAILS**

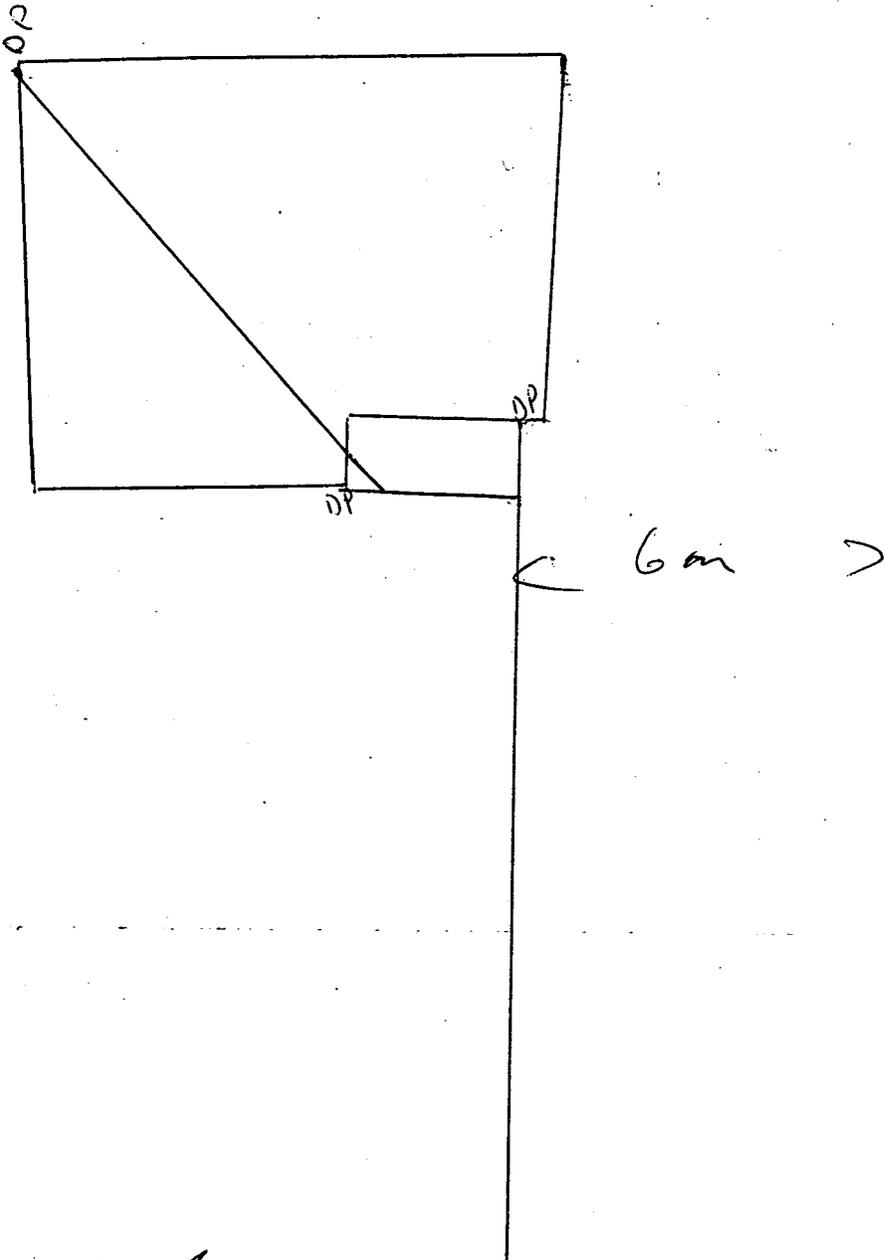

HAMILTON CITY COUNCIL  
**APPROVED**  
SUBJECT TO CONDITIONS  
TO BE KEPT ON SITE

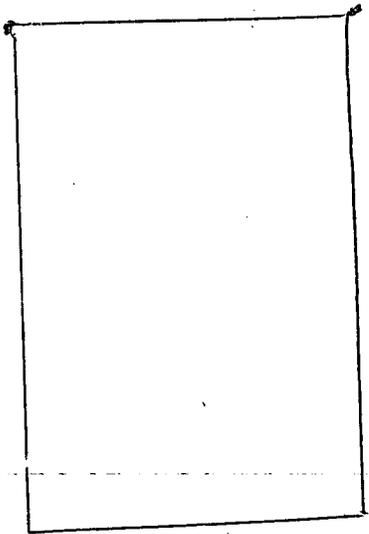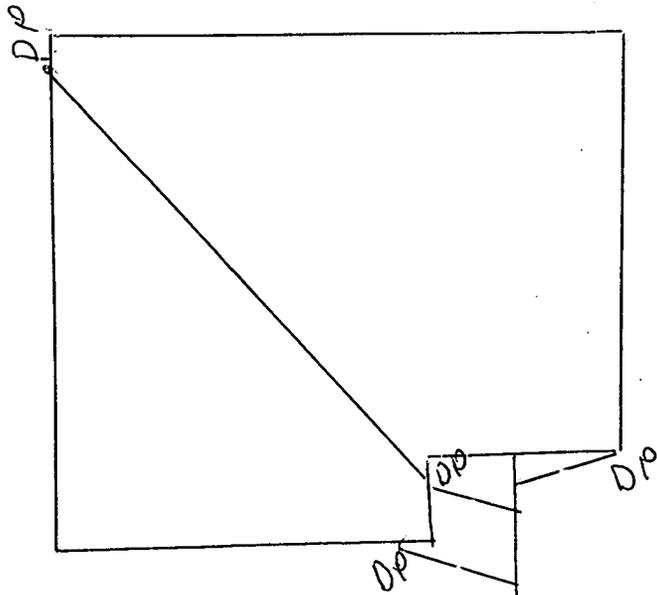

90m Pipe

5m