Drainage 1

Waikato Building Consents

Working Together

As Laid Drainage

Building Consent Number: 2017/36139 Date: 18 / 9 / 17 No. of pages: 1

Builder: R.P.S HOMES

Owner: DEWDNEY RESIDENCE

Address: 3 MALA PLACE HAMILTON, LOT 358

Drain Layer Name: A.WEREN (Please print clearly) Signature:

Registration Number: 23979 Business Name: DRAINAGE SYSTEMS

To Council: (Tick) ☐ Hauraki ☐ Matamata Piako ☐ Waitomo ☐ Otorohanga ☐ Thames Coromandel ☐ Waipa ☐ Waikato ☑ Hamilton

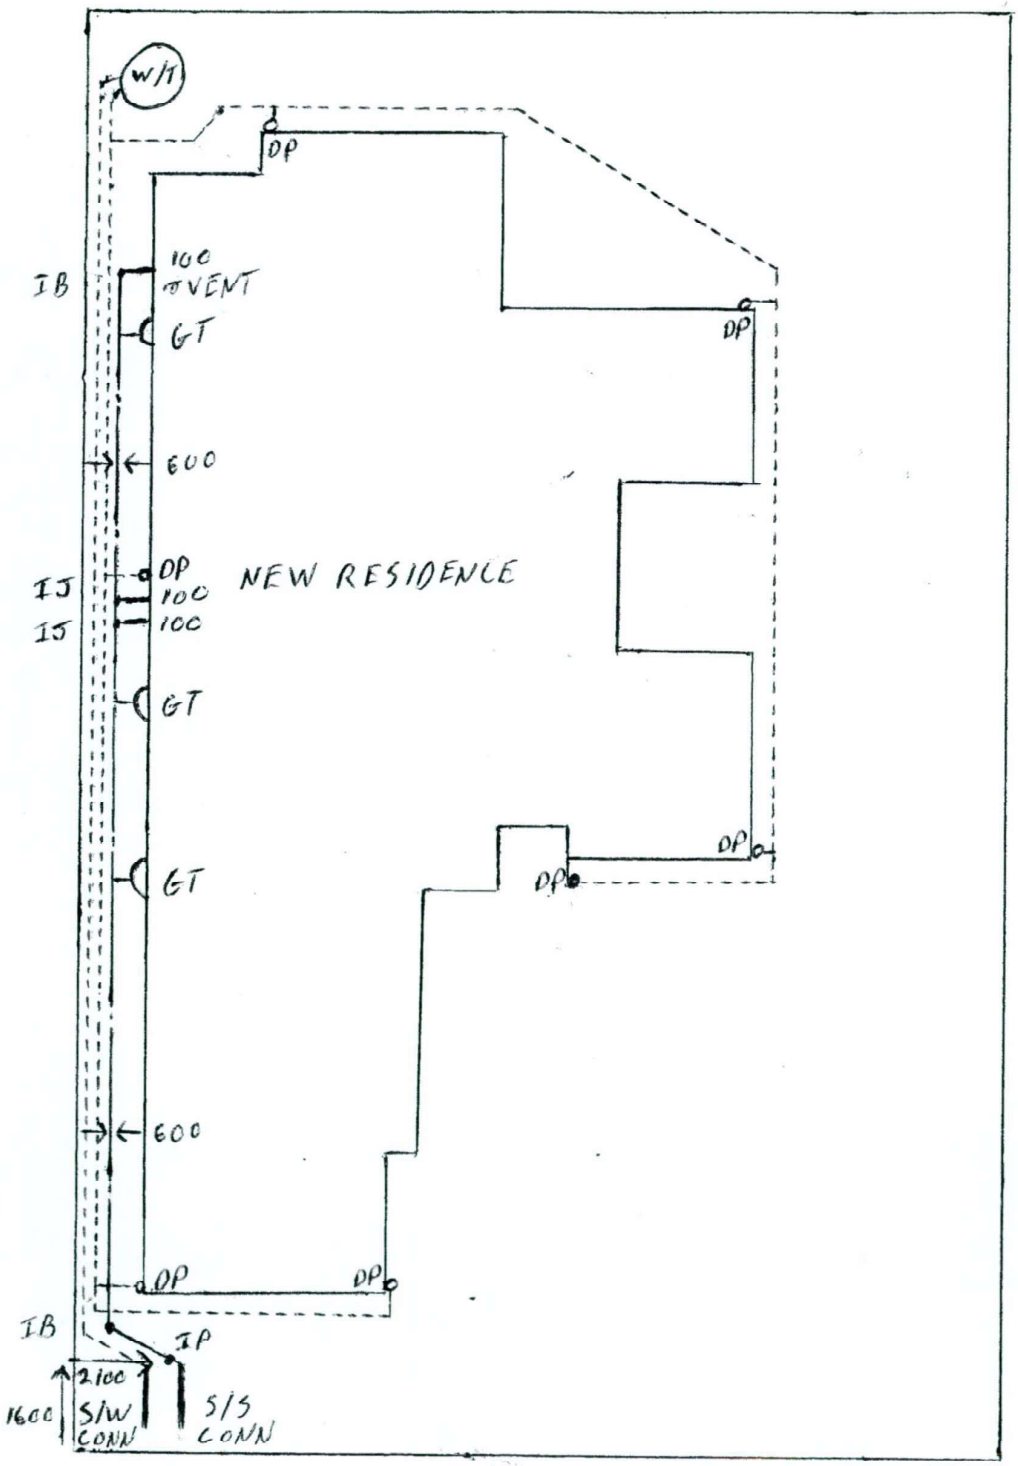

HAURAKI DISTRICT COUNCIL · matamata piako district council · Waitomo District Council · OTOROHANGA DISTRICT COUNCIL · Waipa DISTRICT COUNCIL · Waikato DISTRICT COUNCIL · THAMES COROMANDEL DISTRICT COUNCIL · Hamilton City Council Te kaunihera o Kirikiriroa