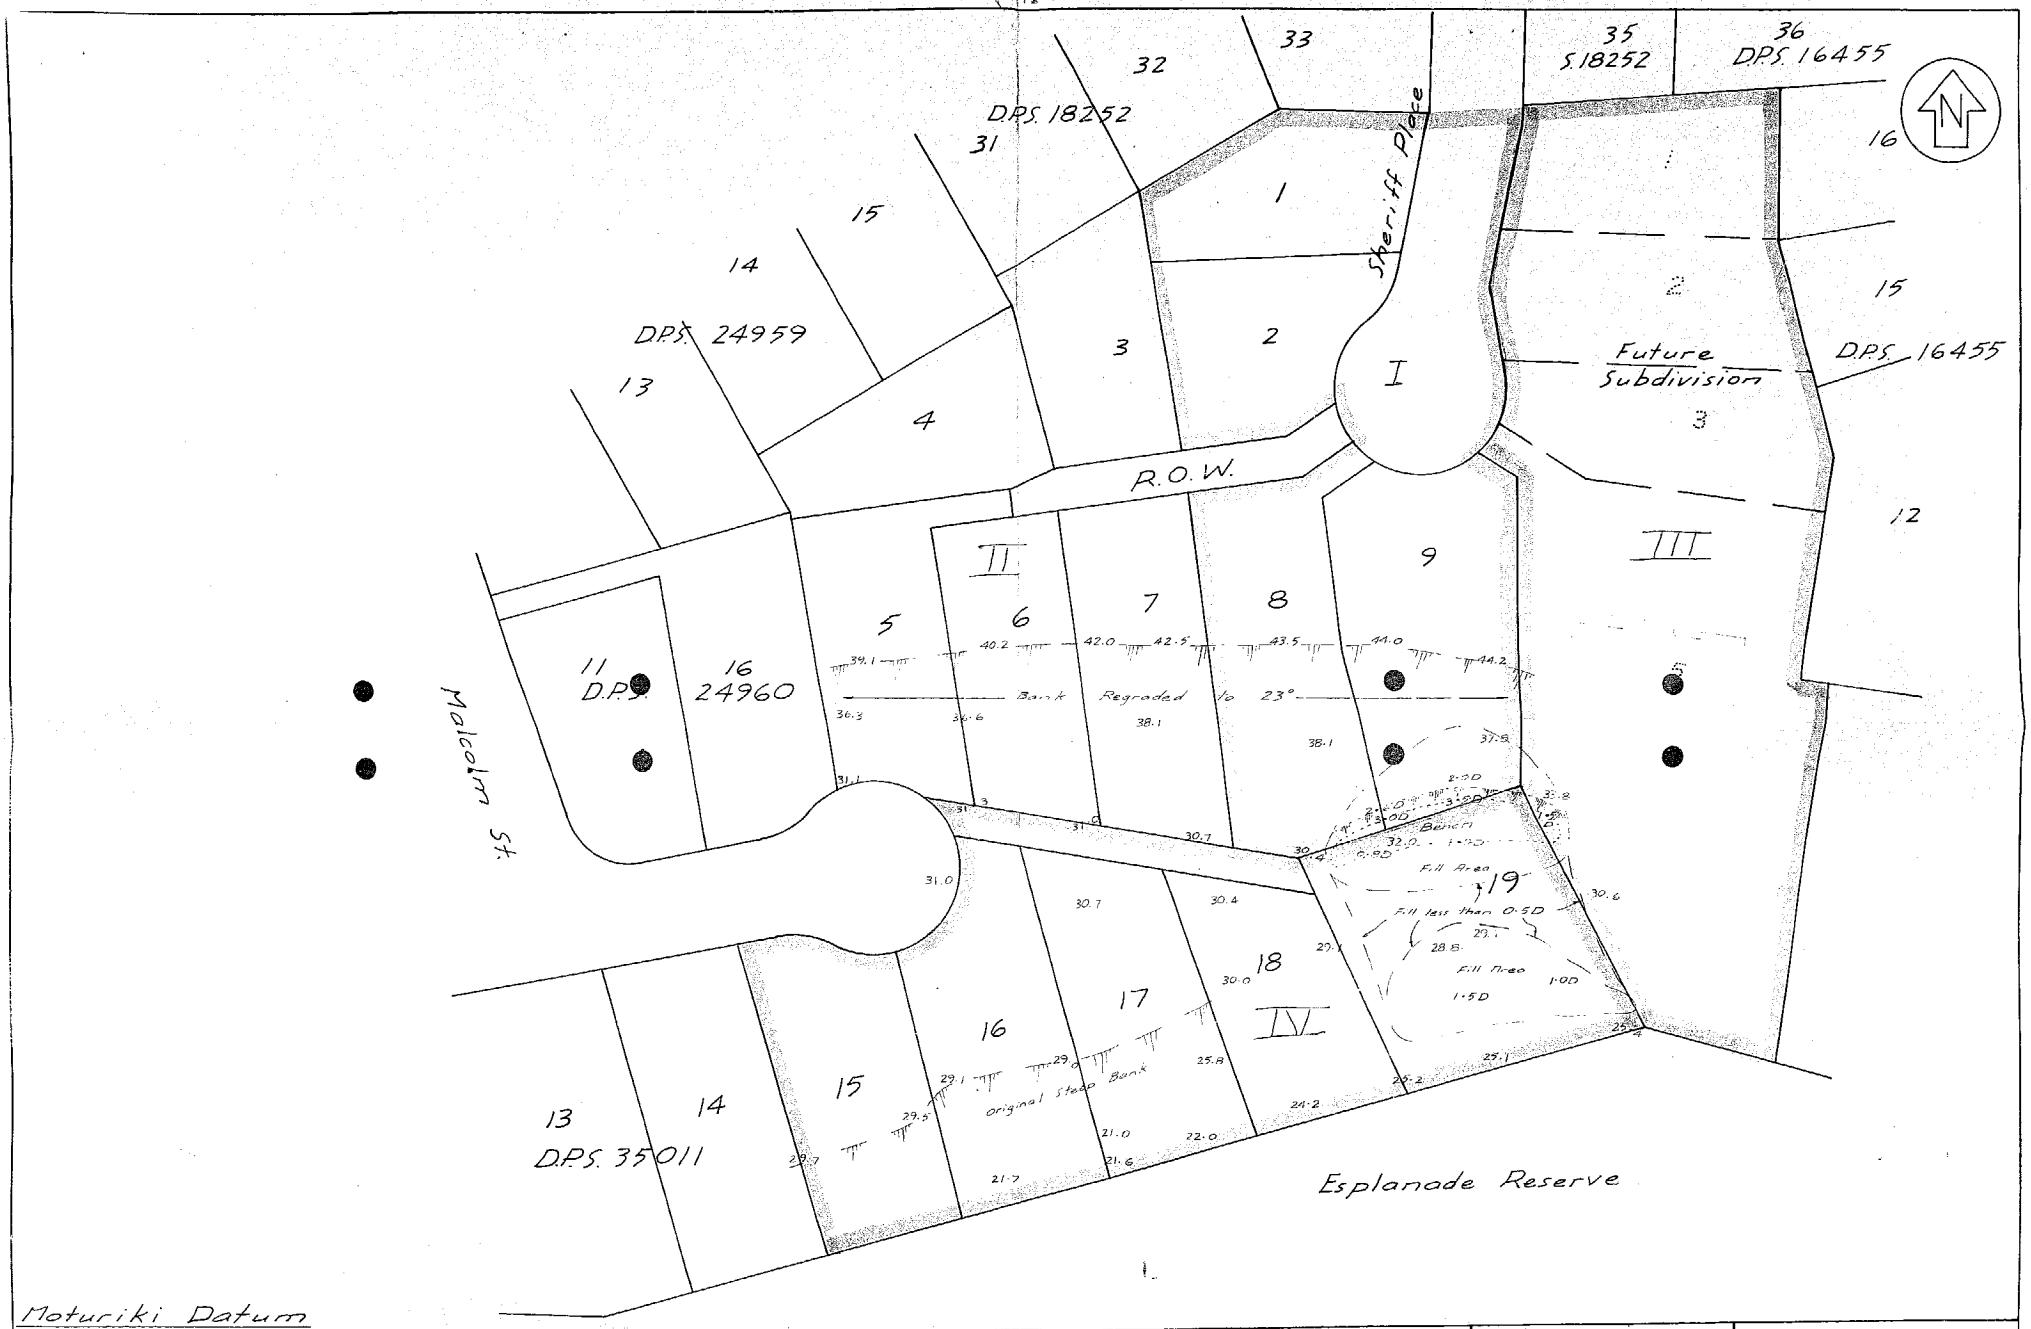

F.1381	Subdivisional Development off Sheriff Place for D.M. MacKenzie	As Built Topographical Plan	Thomson & Farrer Land & Engineering Surveyors July 1986	Scale 1:500	264/7

MICROBOX DOCUMENT MANAGEMENT CO (WAIKATO) HAMILTON 3
3/6/98